

STATE ENGINEER  
Salem, Oregon

TILL  
634

# OBSERVATION WELL Well Record


STATE WELL NO. 1/10W-26B(1)  
COUNTY Tillamook  
APPLICATION NO. GR-2089  
GR-2007

OWNER: Rudolph John Fenk  
MAILING ADDRESS: Star Rt. W., Box 21

LOCATION OF WELL: Owner's No. CITY AND STATE: Tillamook, Oregon

N. E. NW 1/4 NE 1/4 Sec. 26 T. 1 S., R. 10 W., W.M.

Bearing and distance from section or subdivision  
corner 900' S. & 2000' W. from NE Corner, Sec. 26

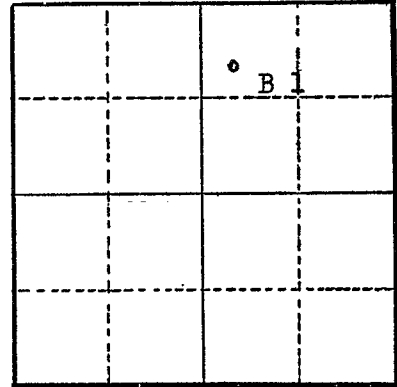

Section 26

Altitude at well

TYPE OF WELL: Drilled Date Constructed 1952

Depth drilled 76 Depth cased 76

### CASING RECORD:

8 inch

### FINISH:

### AQUIFERS:

### WATER LEVEL:

5 feet below land surface

PUMPING EQUIPMENT: Type Cent. H.P. 5  
Capacity G.P.M.

### WELL TESTS:

Drawdown 3 ft. after hours Pumping 172 G.P.M.  
Drawdown ft. after hours G.P.M.

USE OF WATER Irrigation Temp. °F. 19

SOURCE OF INFORMATION GR-2089

DRILLER or DIGGER Wilcox Drilling Co.

### ADDITIONAL DATA:

Log Water Level Measurements Chemical Analysis Aquifer Test

### REMARKS:

Log not available.