

STATE ENGINEER
Salem, Oregon

TILL
635

Well Record

STATE WELL NO. 1/10W-26 Q(1)
COUNTY Tillamook
APPLICATION NO. GR-3350

OWNER: Arnold Walker


MAILING ADDRESS: Route 3, Box 16

LOCATION OF WELL: Owner's No.

CITY AND STATE: Tillamook, Oregon

Govt. Lot 5
SW 1/4 SE 1/4 Sec. 26 T. 1 N. S. R. 10 W., W.M.

Bearing and distance from section or subdivision corner
1613.30' S. and 3035.39' E.
from 1/4 cor. between sec. 26 & 27

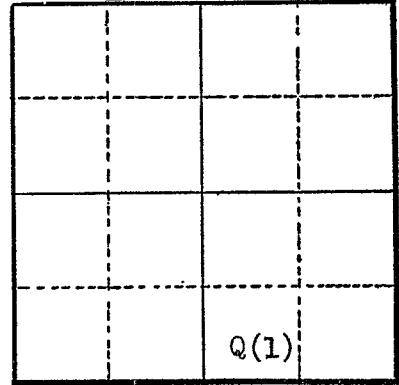

Section

Altitude at well

TYPE OF WELL: drilled Date Constructed 1952

Depth drilled 120' Depth cased 120'

CASING RECORD:

8"

FINISH:

standard punched from 10 to 20"

AQUIFERS:

WATER LEVEL:

7'

PUMPING EQUIPMENT: Type Centrifugal H.P. 15
Capacity 275 G.P.M.

WELL TESTS:

Drawdown 5 ft. after hours pumping 275 G.P.M.
Drawdown ft. after hours G.P.M.

USE OF WATER Irrigation Temp. °F., 19

SOURCE OF INFORMATION GR-3102

DRILLER or DIGGER Ross Aloha

ADDITIONAL DATA:

Log NA Water Level Measurements Chemical Analysis Aquifer Test

REMARKS: