

STATE ENGINEER
Salem, Oregon

TILL
642

Well Record

STATE WELL NO. 1/10W-36Q(1)
COUNTY Tillamook
*APPLICATION NO. GR-2328
Certificate No.

OWNER: Francis M. DeNoble

MAILING ADDRESS: Rt. 3, Box 27


LOCATION OF WELL: Owner's No.

CITY AND STATE: Tillamook, Oregon

Pg 1 of 2

SW 1/4 SE 1/4 Sec. 36 T. 1 N. S, R. 10 E X W., W.M.

Bearing and distance from section or subdivision corner 2100' W. and 600' N. from SE Corner of Sec. 36

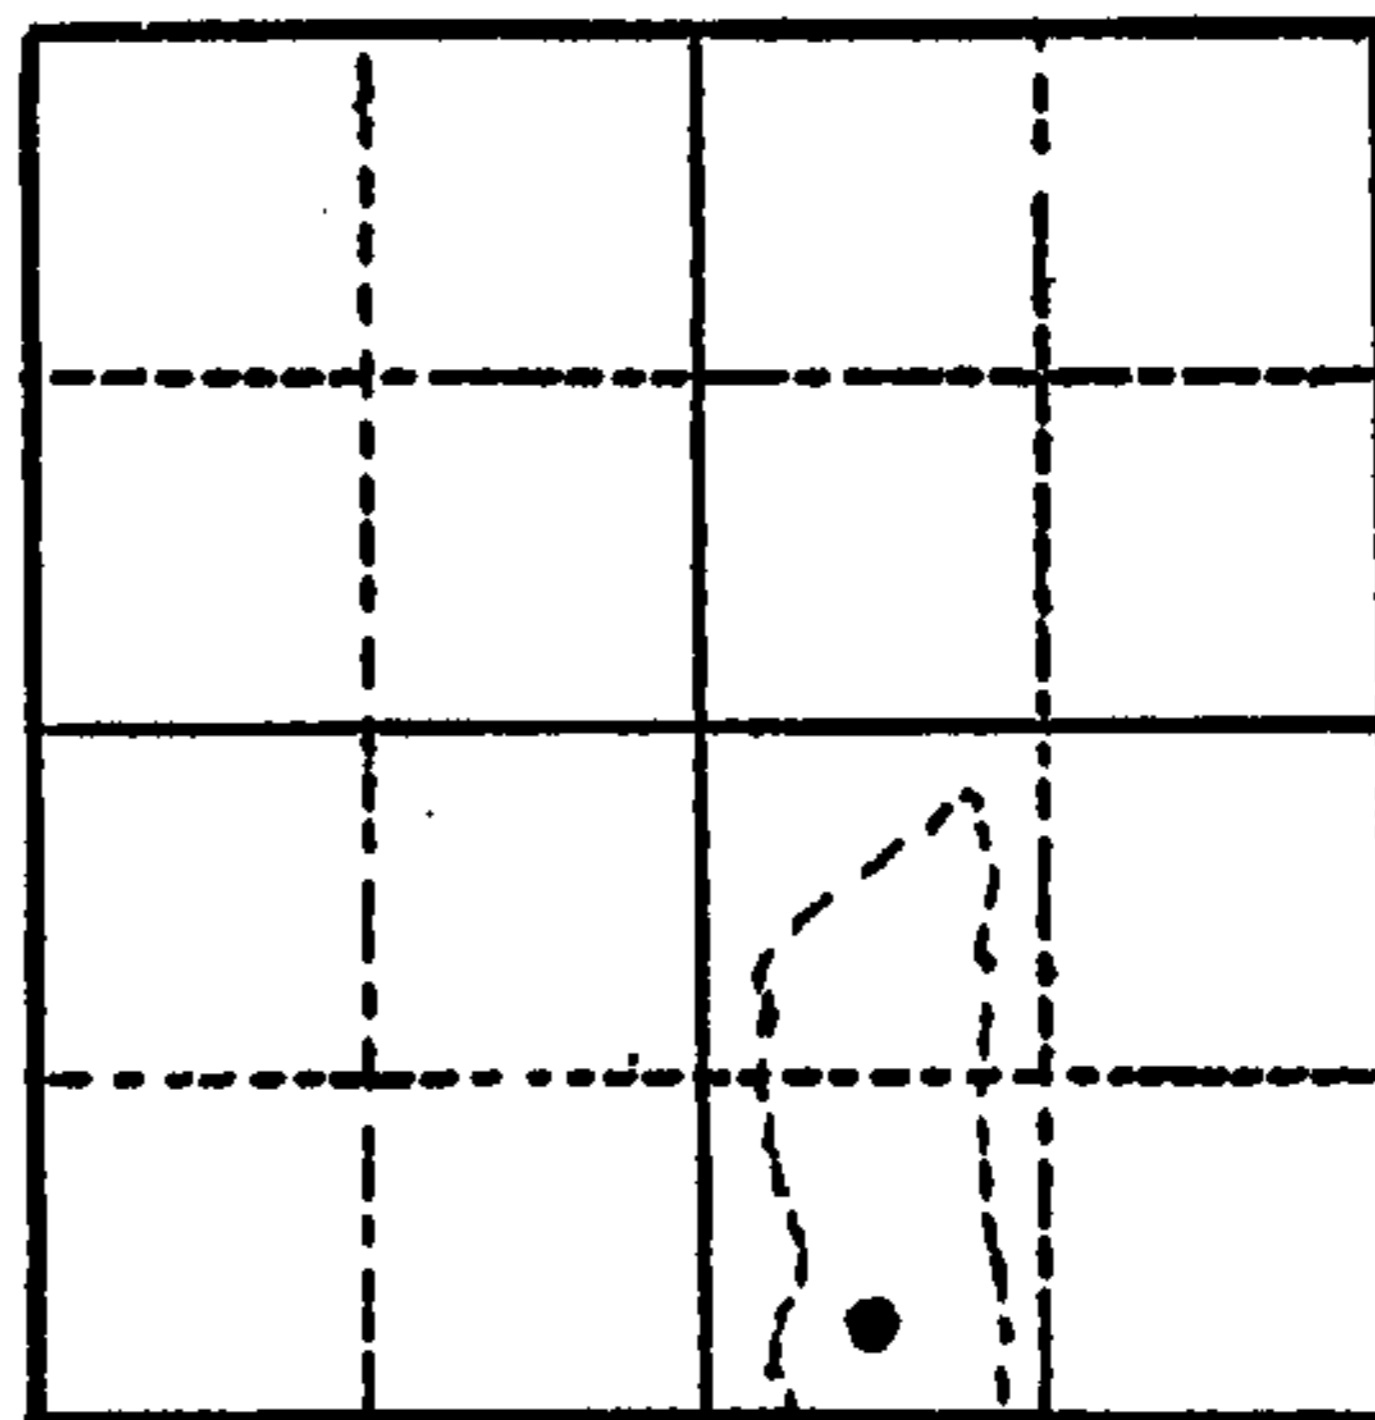

Section 36

Altitude at well

TYPE OF WELL Drilled Date Constructed 1953

Depth drilled 122 Depth cased 92 & 122

CASING RECORD:

- 10 inch
- 10 inch

FINISH:

1 1/4" long-3/8" wide- 12 rows-8' long from 82 to 90

AQUIFERS:

Muck and gravel

WATER LEVEL:

1'

PUMPING EQUIPMENT: Type Deepwell Turbine H.P. 15
Capacity 500 G.P.M.

WELL TESTS:

Drawdown 27 1/2	ft. after	hours	Pumping 550	G.P.M.
25			Pumping 380	
Drawdown 22 1/2	ft. after	hours	Pumping 187	G.P.M.

USE OF WATER Irrigation Temp. °F. 19

SOURCE OF INFORMATION GR-2214

DRILLER or DIGGER

ADDITIONAL DATA:

Log X Water Level Measurements Chemical Analysis Aquifer Test

REMARKS:

