

STATE ENGINEER  
Salem, Oregon

OBSERVATION WELL  
Well Record

STATE WELL NO. 2/9W-6G(1)  
COUNTY Tillamook  
APPLICATION NO. GR-958  
6-4259

65784  
TILL  
657

GR-929

OWNER: M. J. Jenck


MAILING ADDRESS: Rt. 2 Box 50

LOCATION OF WELL: Owner's No.

CITY AND STATE: Tillamook, Oregon

SW 1/4 NE 1/4 Sec. 6 T. 2 S., R. 9 W., W.M.

Bearing and distance from section or subdivision  
corner 410' E. & 675' N. of Center of sec. 6.

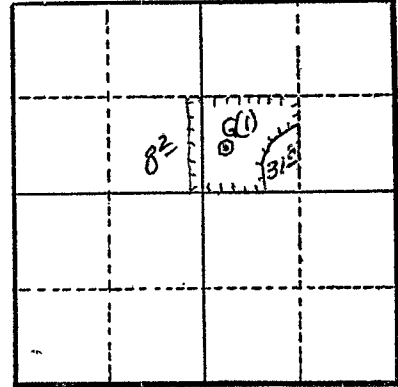

Section 6

Altitude at well 18 ft.

TYPE OF WELL: Drilled Date Constructed 1952

Depth drilled 99 ft. Depth cased 99 ft.

CASING RECORD:

8 inch

FINISH:

Perforated: 1" x 2" one per foot from 40 to 90 ft.

AQUIFERS:

WATER LEVEL:

6 ft.

PUMPING EQUIPMENT: Type G-D Centrifugal (2 1/2 x 3) H.P. 7 1/2

Capacity 250 G.P.M.

WELL TESTS:

Drawdown 21 ft. after 250 hours G.P.M.

Drawdown 17 ft. after 192 hours G.P.M.

USE OF WATER Irrigation Temp. °F. 19

SOURCE OF INFORMATION G.R. Record

DRILLER or DIGGER Paul Ross

ADDITIONAL DATA:

Log N.A. Water Level Measurements Chemical Analysis Aquifer Test

REMARKS:

Irrigation of 40 acres.