

STATE ENGINEER
Salem, Oregon

TILL
658

Well Record

STATE WELL NO. 2/9W - 6J
COUNTY TILLAMOOK
APPLICATION NO. GR-1919

OWNER: Judy Lou Dye & Connie Lee Dye
acting by and thru Harry Elliott, Attorney

MAILING ADDRESS: 2016 2nd. Street


CITY AND STATE: Tillamook, Oregon

LOCATION OF WELL: Owner's No. _____

NE 1/4 SE 1/4 Sec. 6 T. 2 N. S. R. 9 W., W.M.

Bearing and distance from section or subdivision

corner 1000' W. and 400' S. from the
East 1/4 corner of Section 6

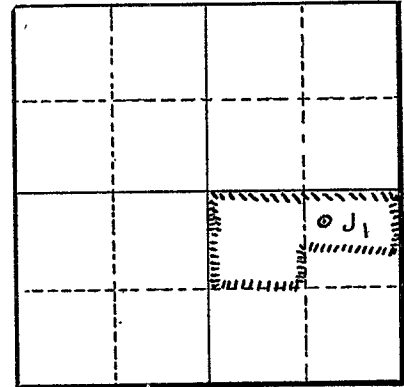

Section 6

Altitude at well _____

TYPE OF WELL: Drilled Date Constructed 1953

Depth drilled 90' Depth cased 90'

CASING RECORD:

8-inch

FINISH:

Casing perforations bottom 10 feet

AQUIFERS:

Sandy loam soil some gravel

WATER LEVEL:

8-feet

PUMPING EQUIPMENT: Type Pacific Pump H.P. 7 1/2
Capacity 500 G.P.M.

WELL TESTS:

Drawdown 6 ft. after _____ hours Pumping 200 G.P.M.
Drawdown _____ ft. after _____ hours _____ G.P.M.

USE OF WATER Irrigation Temp. _____ °F., 19

SOURCE OF INFORMATION GR-1903

DRILLER or DIGGER Paul E. Ross, Aloha, Oregon

ADDITIONAL DATA:

Log _____ Water Level Measurements _____ Chemical Analysis _____ Aquifer Test _____

REMARKS:

No log kept Sandy loam soil, some gravel.