



Oregon Water Resources Department
725 Summer Street NE, Suite A
Salem Oregon 97301
(503) 986-0900
www.wrd.state.or.us

Application for
Well ID Number

Do not complete if the well already has a Well Identification Number.

I. OWNER INFORMATION

Current Owner Name (please print): Pacific City Joint Water-Sanitary Authority (PCJWSA)
Mailing Address: PO Box 520
City, State, Zip: Pacific City, Oregon 97135
Mail Well ID Tag to: [X] SAME AS ABOVE [X] In Care Of (C/O)
Name & Address: Tony Owen
City, State, Zip:

II. WELL LOCATION INFORMATION (Please fill out as completely as possible)

Township: 4 (North / South) Range: 10 (East / West) Section: 19
Tax Lot: 300 County Tillamook I/4 I/4
GPS Coordinates: 45.213109 -123.965048 Nearest: 34005 Cape Kiwanda Dr
Street Address of Well, City: 1200.2' N 11°3'41" E from W1/4 corner of Section 19, SWNW, T4S, R10W (WM)
If the property had a different street address in the past: Above is POD Location per Water Right

III. GENERAL WELL INFORMATION (Please fill out as completely as possible)

Use of Well (domestic, irrigation, commercial, industrial, monitoring): Domestic. PCJWSA ID - Well #2
Date Well Constructed (or property built): 3/1/1984 Total Well Depth: 80' Casing Diameter: 8"
Owner at time the well was constructed (if known): Pacific City Water District (PCWD)
Other Information: PCWD became PCJWSA July 1, 1998. Well Log #TILL 907. Permit #G-10392. Cert.#80488 App 6/11/260

SUBMITTED BY (please print): Tony Owen
PHONE: 503-965-6636 EMAIL &/or FAX: towen@pcjwsa.com 505-965-6056

Send application to: Oregon Water Resources Department 725 Summer St NE, Suite A, Salem, Oregon 97301; or fax to (503) 986-0902. Applications are processed in the order they are received, and Well ID Numbers are mailed within 4-5 business days.

For Official Use Only by the Oregon Water Resources Department:

Received Date:

7-31-15

Well Log Number:


TILL 907

Well Identification #:

L-118746

RECEIVED BY OWRD

TILL 907

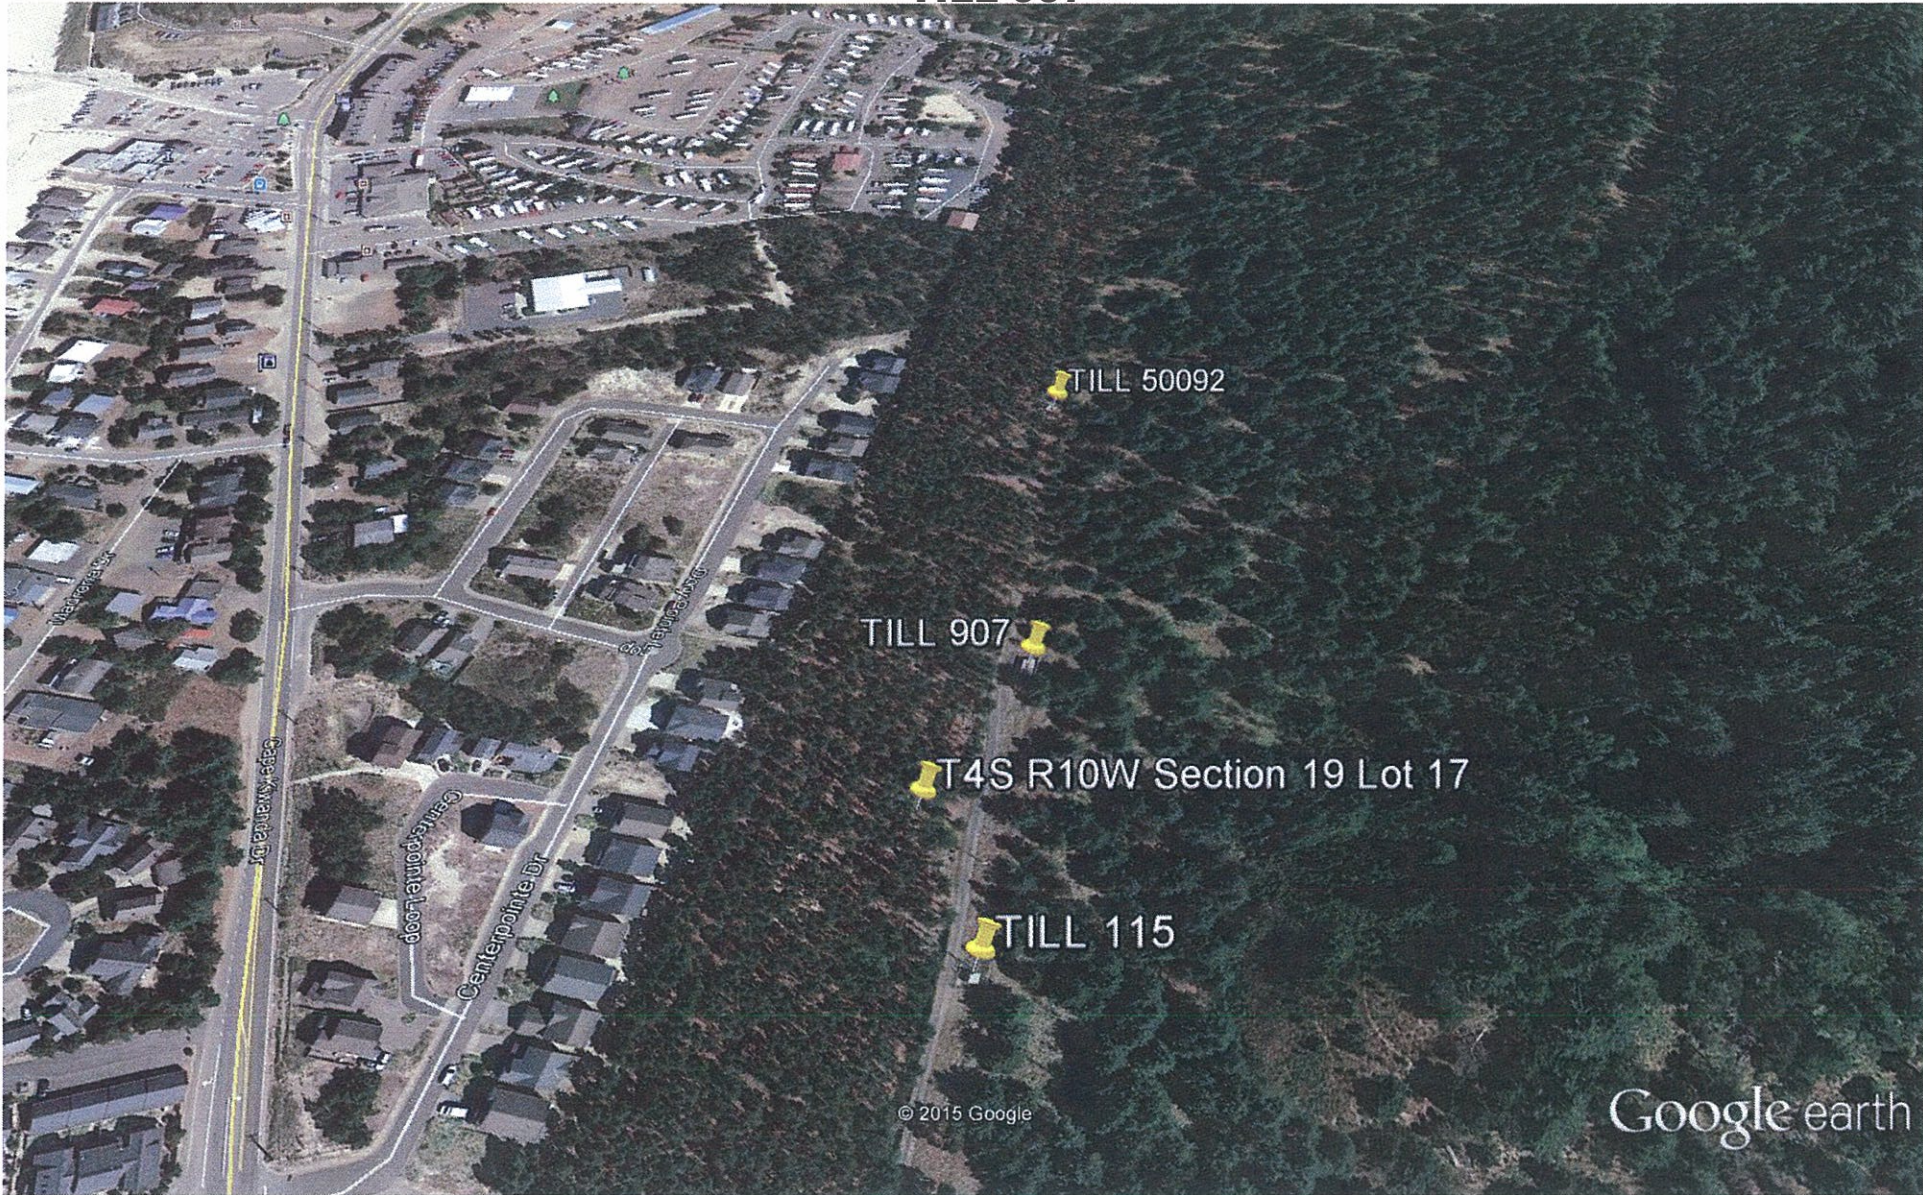

Google earth

