

STATE ENGINEER
Salem, Oregon

TILL
910

OBSERVATION WELL
Well Record

STATE WELL NO. 4/10W-19J
COUNTY Tillamook
APPLICATION NO. GR-3260

OWNER: Lloyd & Elma McKillip


MAILING ADDRESS: Route 2, Box 18

LOCATION OF WELL: Owner's No.

CITY AND STATE: Cloverdale, Oregon

NE 1/4 SE 1/4 Sec. 19 T. 4 N. S., R. 10 W., W.M.

Bearing and distance from section or subdivision corner
28 ch. N. & 19.5 ch. W. from S.E. cor. Sec. 19

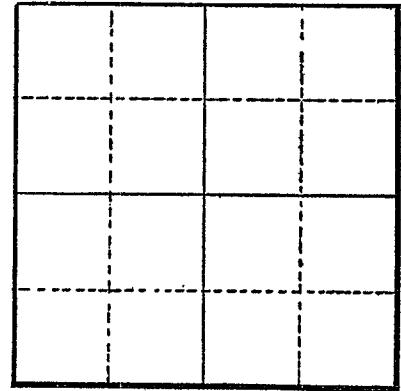

Section

Altitude at well

TYPE OF WELL: drilled Date Constructed 1952

Depth drilled 80 Depth cased

CASING RECORD:

FINISH:

AQUIFERS:

WATER LEVEL:

5 feet

PUMPING EQUIPMENT: Type Cornell Centrifugal H.P. 7 1/2
Capacity 200 G.P.M.

WELL TESTS:

Drawdown ft. after hours G.P.M.
Drawdown ft. after hours G.P.M.

USE OF WATER Irrigation Temp. °F., 19

SOURCE OF INFORMATION GR-3033

DRILLER or DIGGER Willcox Drilling Co., McMinnville, Oregon

ADDITIONAL DATA:

Log Water Level Measurements Chemical Analysis Aquifer Test

REMARKS: