

STATE ENGINEER  
Salem, Oregon

TILL  
926

OBSERVATION WELL  
Well Record


STATE WELL NO. 4/10W-27F  
COUNTY TILLAMOOK  
APPLICATION NO. GR-2623

OWNER: Victor Werth (JAMES C. TRENT) MAILING ADDRESS: Cloverdale, Oregon

LOCATION OF WELL: Owner's No. CITY AND STATE:

SE 1/4 NW 1/4 Sec. 27 T. 4 S., R. 10 W., W.M.

Bearing and distance from section or subdivision corner 1042' N. and 735' W.

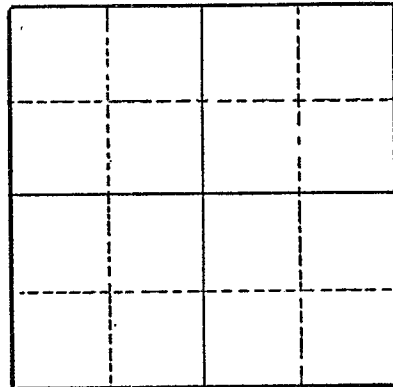

Section

Altitude at well

TYPE OF WELL: Drilled Date Constructed 1951

Depth drilled 82 Depth cased 82

CASING RECORD:

8-inch

FINISH:

Perforated from 25 to 35  
and gain from 65 to 82

AQUIFERS:

Loam, Dobie, Sand, Gravel, Boulders and rock

WATER LEVEL:

6 to 8-feet

PUMPING EQUIPMENT: Type Pacific Centrifugal H.P. 5  
Capacity 90 G.P.M.

WELL TESTS:

Drawdown 14 ft. after hours Pumping 90 G.P.M.  
Drawdown 20 ft. after hours Pumping 130 G.P.M.

USE OF WATER Irrigation Temp. °F. 19

SOURCE OF INFORMATION GR-2488

DRILLER or DIGGER Paul Ross, Aloha, Oregon

ADDITIONAL DATA:

Log  Water Level Measurements  Chemical Analysis  Aquifer Test

REMARKS:

Bottom loam 4"  
Blue Dobie 21"  
Sand to Gravel 10"  
Blue Dobie 30"  
Sand, Gravel, and boulders 16"  
Solid Rock 1"