NOTICE TO WATER WELL CONTRACTOR The original and first copy of this report are to be

UMAT 1051 WATER WELL REPORT UMA


2N/33-28+

state engineer, salem, or content to the within 30 days from the last APR 14 1971 (Do not write above this line)

State	Well	No.		- 10	 	 	
State	Pern	nit N	To.	**********	 	 	

STATE ENGINEER					
(1) OWNER: SALEM. ORLEGN	(10) LOCATION OF WELL: Lot	<i>†</i>			
Name Leonard Wells	County Umatilla Driller's well nu	mber No.	1.		
Address 1102 SW 30th, Pendleton, Oregon	SW 14 NW 14 Section 28 T. 2N	R. 33	E w.m.		
	Bearing and distance from section or subdivision	on corner			
(2) TYPE OF WORK (check):					
New Well 🔀 Deepening 🗌 Reconditioning 🗍 Abandon 🗍					
If abandonment, describe material and procedure in Item 12.	(11) WATER LEVEL: Completed w	ell.			
(3) TYPE OF WELL: (4) PROPOSED USE (check):	Depth at which water was first found	80	ft.		
Rotary Driven Domestic Mindustrial Municipal Domestic	Static level 18 ft. below land s	urface. Date	3-7-71		
Cable	Artesian pressure lbs. per square	e inch. Date			
CASING INSTALLED: Threaded Welded X 10 " Diam. from 0 ft. to 34 ft. Gage 250 6 " Diam. from 0 ft. to 5.5 ft. Gage 250 " Diam. from ft. to ft. Gage 250 ft. Gage 250 Carrest Constant Con	(12) WELL LOG: Diameter of well be Depth drilled 200 ft. Depth of complete Formation: Describe color, texture, grain size a and show thickness and nature of each stratum with at least one entry for each change of format	eted well and structure of an and aquifer plion. Report each	enetrated, change in		
PERFORATIONS: Perforated? ☐ Yes ☐ No.	position of Static Water Level and indicate princ	· 1			
Lype of perforator used	MATERIAL	From To	SWL		
Size of perforations in. by in.	Top soil, Dark Brown	0 3			
perforations from ft, to ft.	Claystone, Light Brown	3 6	 		
perforations from ft. to ft.	Boulders, Gravel, Coarse		+		
perforations from ft. to ft.	Clay, Brown	25 30	}		
(7) SCREENS: Well screen installed? Yes No	Basalt, Brown	30 55 55 80			
Manufacturer's Name	Broken Basalt, Br. & Blk.		WATER		
Type	Basalt, Blk. Hard	230	 		
Diam. Slot size Set from ft. to ft.	-Basalt, Gray	95 200			
Diam Slot size Set from ft. to ft.			 		
(8) WELL TESTS: Drawdown is amount water level is lowered below static level					
Was a pump test made? ☐ Yes ★ No If yes, by whom?					
Yield: 60 gal./min. with 15 ft. drawdown after 2 hrs.			<u> </u>		
AIR TEST " "			<u> </u>		
		 	 		
Bailer test gal./min. with ft. drawdown after hrs.			 -		
		-	+		
Artesian flow g.p.m. perature of water 54 Depth artesian flow encountered		Manch 0	+h 10 7		
	Work started March 4 19 71 Complete				
CONSTRUCTION: 6" set to 55'	Date well drilling machine moved off of well M		19 / -		
Well seal—Material used Cement Pressure grouted	Drilling Machine Operator's Certification:				
Well sealed from land surface to 34&55 to surface ft.	This well was constructed under my Materials used and information reported	direct supe	rvision. le to my		
Diameter of well bore to bottom of seal 14_ in.	best knowledge and belief.				
Diameter of well bore below seal in.	[Signed] (Drilling Machine Operator)	Date April	,1 19 7 .1		
Number of sacks of cement used in well seal 25sacks	Drilling Machine Operator's License No. 6.78				
Number of sacks of bentonite used in well seal sacks	Drining Machine Operator's Intense No				
Brand name of bentonite	Water Well Contractor's Certification:				
Number of pounds of bentonite per 100 gallons	This well was drilled under my jurisdi	ction and this	report is		
of water Ibs./100 gals.	true to the best of my knowledge and belief.				
Was a drive shoe used? ☐ Yes ☑ No Plugs Size: location ft.	Name PROJECT: Corporation	(Tuna or -	mnt)		
Did any strata contain unusable water?	Person, firm or corporation) 24 North 2nd, Walla	Walla	Wň.		
Type of water? depth of strata	Address	<i></i>	**************		
Method of sealing strata off	[Signed] / Well for the state of the state o				
Was well gravel packed? Yes No Size of gravel:	(Water Well Contr		71		
Gravel placed from ft. to ft.	Contractor's License No512 Date	·brrr /fb	L, 19/. .		


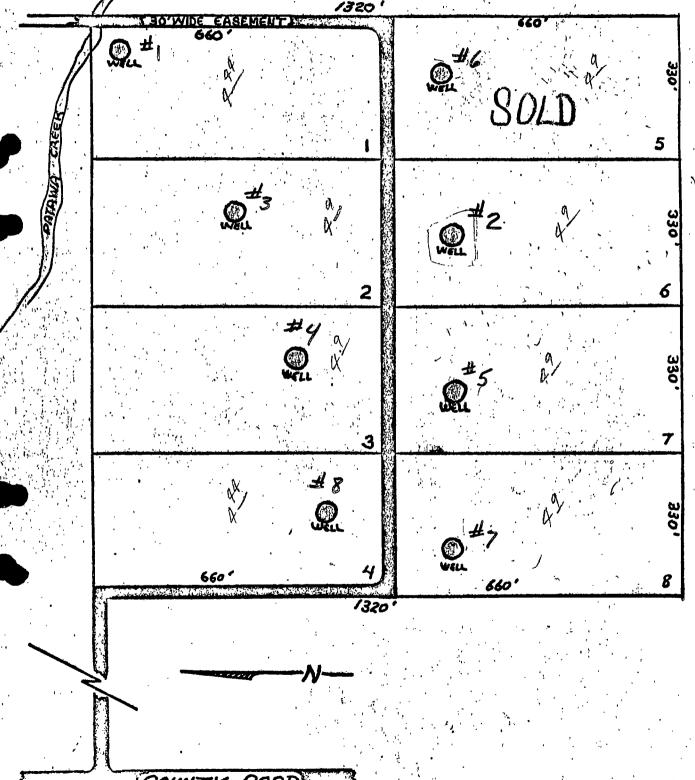

COUNTY ROAD