

UMAT
11

Well Record

STATE WELL NO. 6N/35-15K
COUNTY Umatilla
APPLICATION NO. GR-3843

OWNER: Tom & Jesse Chandler

MAILING ADDRESS: Route 3, Box 24


LOCATION OF WELL: Owner's No. _____

CITY AND STATE: Milton-Freewater, Oregon

NW ¼ SE ¼ Sec. 15 T. 6 N. E, R. 35 W., W.M.

Bearing and distance from section or subdivision

corner 620' E. & 20' N. of SW Cor. Sec. 15

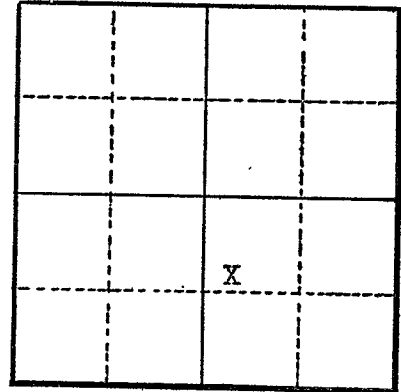

Section 15

Altitude at well _____

TYPE OF WELL: Dug 30' Drill 40' Date Constructed 1921

Depth drilled 70 ft. Depth cased 44 ft.

CASING RECORD:

86 in. concrete from 0 to 25 feet
8 inch steel casing from 28 to 44 feet

FINISH:

AQUIFERS:

WATER LEVEL:

30 feet below surface

PUMPING EQUIPMENT: Type Gould pump centrifugal 2½" H.P. 7½
Capacity 250 G.P.M.

WELL TESTS:

Drawdown _____ ft. after _____ hours _____ G.P.M.

Drawdown _____ ft. after _____ hours _____ G.P.M.

USE OF WATER Irrigation Temp. _____ °F., 19____

SOURCE OF INFORMATION Well Registration Statement Cert. # GR-3741

DRILLER or DIGGER _____

ADDITIONAL DATA:

Log _____ Water Level Measurements _____ Chemical Analysis _____ Aquifer Test _____

REMARKS: