

STATE ENGINEER  
Salem, Oregon

UMAT  
1140

# Well Record

STATE WELL NO. 2N/35-3E (1)  
COUNTY Umatilla  
APPLICATION NO. U-630

OWNER: Mrs. Merle Jack Cahill


MAILING ADDRESS: Box 5

LOCATION OF WELL: Owner's No. 1

CITY AND STATE: Adams, Oregon

SW  $\frac{1}{4}$  NW  $\frac{1}{4}$  Sec. 3 T. 2 <sup>N.</sup> S., R. 35 <sup>E.</sup> W., W.M.

Bearing and distance from section or subdivision corner 850 ft. E. and 530 ft. N. from W $\frac{1}{4}$  corner of Sec. 3, T. 2 N., R. 35 E., W.M.

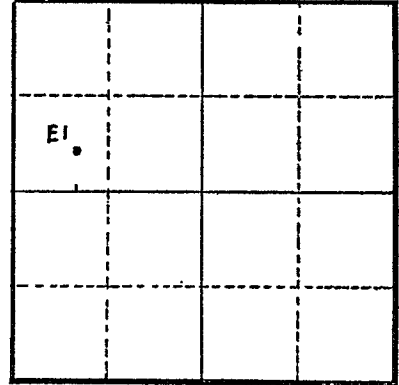

Section 3

Altitude at well \_\_\_\_\_

TYPE OF WELL: Dug Date Constructed 1930

Depth drilled 10 feet Depth cased \_\_\_\_\_

CASING RECORD:

FINISH:

AQUIFERS:

WATER LEVEL:

7 ft. 1953;

PUMPING EQUIPMENT: Type Rain Flow H.P. 5  
Capacity 600 G.P.M.

WELL TESTS:

Drawdown \_\_\_\_\_ ft. after \_\_\_\_\_ hours \_\_\_\_\_ G.P.M.

Drawdown \_\_\_\_\_ ft. after \_\_\_\_\_ hours \_\_\_\_\_ G.P.M.

USE OF WATER Irrigation Temp. \_\_\_\_\_ °F., 19\_\_\_\_\_

SOURCE OF INFORMATION \_\_\_\_\_

DRILLER or DIGGER \_\_\_\_\_

ADDITIONAL DATA:

Log \_\_\_\_\_ Water Level Measurements \_\_\_\_\_ Chemical Analysis \_\_\_\_\_ Aquifer Test \_\_\_\_\_

REMARKS: