

UMAT
1204

Well Record

STATE WELL NO. 3N/28-18K(1)
COUNTY Umatilla
APPLICATION NO. G- 407

OWNER: Harry J. Andrews

MAILING ADDRESS:


LOCATION OF WELL: Owner's No. _____

CITY AND STATE:

NW $\frac{1}{4}$ SE $\frac{1}{4}$ Sec. 18 T. 3 ~~N.~~ R. 28 ~~E.~~ W.M.

Bearing and distance from section or subdivision

corner N.70°05'E. 3834.9' from SW cor. sec. 18

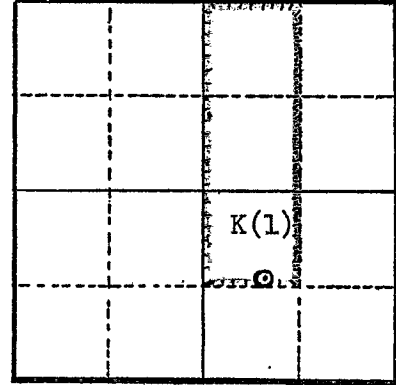

Section 18

Altitude at well _____

TYPE OF WELL: Drilled Date Constructed _____

Depth drilled _____ Depth cased _____

CASING RECORD:
12 inch

FINISH:

AQUIFERS:

WATER LEVEL:

PUMPING EQUIPMENT: Type _____ H.P. _____
Capacity _____ G.P.M.

WELL TESTS:

Drawdown _____ ft. after _____ hours _____ G.P.M.

Drawdown _____ ft. after _____ hours _____ G.P.M.

USE OF WATER Irrigation Temp. _____ °F. _____, 19_____

SOURCE OF INFORMATION G- 330

DRILLER or DIGGER _____

ADDITIONAL DATA:

Log NA Water Level Measurements _____ Chemical Analysis _____ Aquifer Test _____

REMARKS:

(1-30-58) Owner reports that well has been drilled to 630' and obtained 480 gpm. As this quantity was not sufficient, Mr. Andrews intends to drill deeper. Has a permit for 1.5 cfs to irrigate 120 acres.