

STATE ENGINEER
Salem, Oregon

UMAT
1261

Well Record

STATE WELL NO. 3N/29-5G(1)
COUNTY Umatilla
APPLICATION NO. U- 471

OWNER: Carol Northrop

MAILING ADDRESS: Rt. 2 Box 26C

LOCATION OF WELL: Owner's No.

CITY AND STATE: Hermiston, Oregon

NE 1/4 NW 1/4 Sec. 5 T. 3 N. 29 E. W.M.


Bearing and distance from section or subdivision

corner

Altitude at well

TYPE OF WELL: Drilled Date Constructed 1952

Depth drilled 235' Depth cased

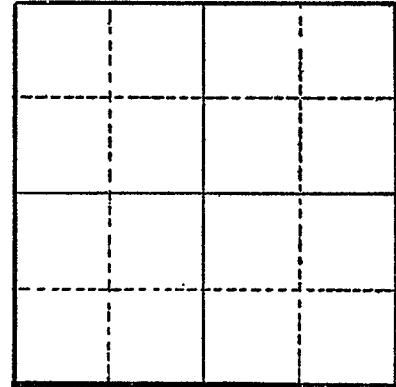

Section 5

CASING RECORD:

6 inch

FINISH:

AQUIFERS:

WATER LEVEL:

75 feet in 1952

PUMPING EQUIPMENT: Type H.P.
Capacity G.P.M.

WELL TESTS:

Drawdown ft. after hours G.P.M.
Drawdown ft. after hours G.P.M.

USE OF WATER Irrigation - 6 ac. @ 1/80 cfs Temp. °F., 19

SOURCE OF INFORMATION U- 427

DRILLER or DIGGER Ben Dreyer

ADDITIONAL DATA:

Log Water Level Measurements Chemical Analysis Aquifer Test

REMARKS:

Old well, no record	0 to 80
Black rock, hard	80 to 116
Black sand	116 to 132
Black rock	132 to 204
Black rock, soft	204 to 235