

STATE ENGINEER
Salem, Oregon

UMAT
1400

Well Record

STATE WELL NO. 3N/32-22C
COUNTY Umatilla
APPLICATION NO. GR-4140

OWNER: George Mumm

MAILING

ADDRESS: Holdman Route

LOCATION OF WELL: Owner's No.


CITY AND

STATE: Pendleton, Oregon

NE 1/4 NW 1/4 Sec. 22 T. 3 N. R. 32 E. W.M.

Bearing and distance from section or subdivision

corner

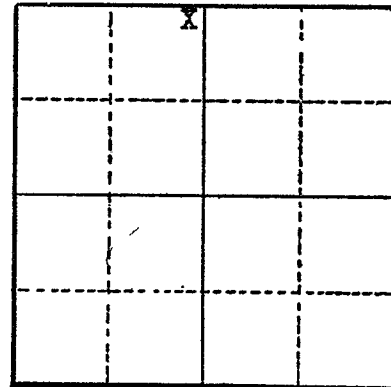

Section 22

Altitude at well

TYPE OF WELL: Drilled Date Constructed 1904

Depth drilled 429 ft. Depth cased 429 ft.

CASING RECORD:

6 inch well casing set to 10 feet

6 inch uncased (rock from 10 to 429 feet)

FINISH:

AQUIFERS:

WATER LEVEL:

380 feet below surface

PUMPING EQUIPMENT: Type plunger type 10" stroke H.P. 3
Capacity 6 G.P.M.

WELL TESTS:

Drawdown ft. after hours G.P.M.

Drawdown ft. after hours G.P.M.

USE OF WATER Irrigation Temp. °F. 19

SOURCE OF INFORMATION Well Registration Statement Cert. # GR-3715

DRILLER or DIGGER

ADDITIONAL DATA:

Log X Water Level Measurements Chemical Analysis Aquifer Test

REMARKS:

Log

Soil

Hard pan

Basalt rock

Thickness

5 1/4

4 3/4

419

Depth to Bottom

5 1/4

10

429