

STATE ENGINEER
Salem, Oregon

UMAT
1404

Well Record

STATE WELL NO. 3N/32-29D
COUNTY Umatilla
APPLICATION NO. GR-3272

OWNER: Clarence A. & Lorena Miller

MAILING

ADDRESS: Box 213

LOCATION OF WELL: Owner's No.


CITY AND

STATE: Pendleton, Oregon

NW 1/4 NW 1/4 Sec. 29 T. 3 N. R. 32 E. W.M.

Bearing and distance from section or subdivision

corner 500' S. & 500' E. of NW cor.

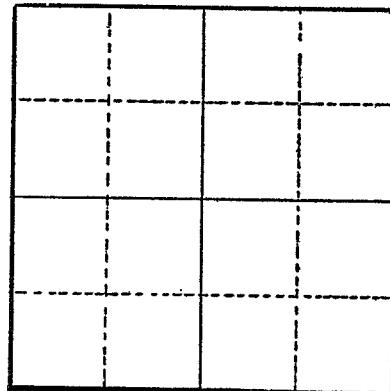

Section

Altitude at well

TYPE OF WELL: drilled Date Constructed 1904

Depth drilled 365 Depth cased 365

CASING RECORD:

6 inch

FINISH:

AQUIFERS:

WATER LEVEL:

100 feet

PUMPING EQUIPMENT: Type Pacific

H.P. 2

Capacity 10 G.P.M.

WELL TESTS:

Drawdown 0 ft. after hours pumping 10 G.P.M.

Drawdown ft. after hours G.P.M.

USE OF WATER Irrigation

Temp. °F. 19

SOURCE OF INFORMATION GR-3043

DRILLER or DIGGER

ADDITIONAL DATA:

Log Water Level Measurements Chemical Analysis Aquifer Test

REMARKS: