

STATE ENGINEER  
Salem, Oregon

UMAT  
1713

# Well Record

STATE WELL NO. 4N/28-1R(1)  
COUNTY Umatilla  
APPLICATION NO. U-449

OWNER: Milton D. Vernon

MAILING  
ADDRESS:


LOCATION OF WELL: Owner's No. \_\_\_\_\_

CITY AND  
STATE:

Hermiston, Oregon

SE ¼ SE ¼ Sec. 1 T. 4 N. 28 E. XX, R. XX, W.M.

Bearing and distance from section or subdivision  
corner 992' N. & 652' W. of SE cor. SW ¼ SE ¼ SE ¼ of  
section 1

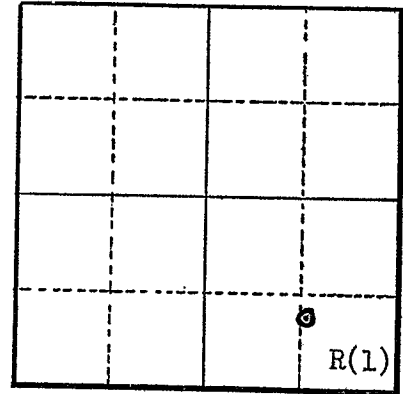

Altitude at well \_\_\_\_\_

TYPE OF WELL: Dug Date Constructed Jun-Oct '52

Depth drilled 27' Depth cased 27'

Section 1

### CASING RECORD:

48 inch - concrete

### FINISH:

### AQUIFERS:

SAND from 0 to 27 feet

### WATER LEVEL:

8 feet

PUMPING EQUIPMENT: Type Cal State 2" centrifugal H.P. 3  
Capacity 65 G.P.M.

### WELL TESTS:

Drawdown 3 ft. after \_\_\_\_\_ hours 65 G.P.M.

Drawdown \_\_\_\_\_ ft. after \_\_\_\_\_ hours \_\_\_\_\_ G.P.M.

USE OF WATER Irrigation (3.2 acres) Temp. \_\_\_\_\_ °F., 19

SOURCE OF INFORMATION U-421

DRILLER or DIGGER \_\_\_\_\_

### ADDITIONAL DATA:

Log X Water Level Measurements \_\_\_\_\_ Chemical Analysis \_\_\_\_\_ Aquifer Test \_\_\_\_\_

### REMARKS:

Sand 0 to 27