

STATE ENGINEER
Salem, Oregon

UMAT
3082
2707

Well Record

STATE WELL NO. 4/35-15P2
COUNTY UMATILLA
APPLICATION NO.

OWNER: Eastern Oregon Food Coop MAILING ADDRESS:

LOCATION OF WELL: Owner's No. CITY AND STATE:


1/4 1/4 Sec. T. N. E. S, R. W., W.M.

Bearing and distance from section or subdivision corner

Altitude at well 1.775

TYPE OF WELL: Drilled Date Constructed

Depth drilled 1.200 Depth cased

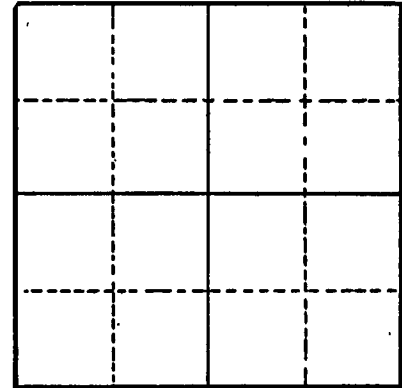

Section

CASING RECORD:

FINISH:

AQUIFERS:

Basalt

WATER LEVEL:

11 at 200' 64' at 1200'

PUMPING EQUIPMENT: Type Turbine H.P.

Capacity 1.200 G.P.M.

WELL TESTS:

Drawdown ft. after hours G.P.M.

Drawdown ft. after hours G.P.M.

USE OF WATER Industrial Temp. °F. 19

SOURCE OF INFORMATION USGS

DRILLER or DIGGER

ADDITIONAL DATA:

Log X Water Level Measurements Chemical Analysis Aquifer Test

REMARKS:

STATE ENGINEER
Salem, Oregon

State Well No. 4/35-15P2

County UMATILLA

Application No.

Well Log

Owner: Eastern Oregon Food Cooperative Owner's No.

Driller: A. A. Durand and Son Date Drilled 1946

CHARACTER OF MATERIAL	(Feet below 'and surface)		Thickness (feet)
	From	To	
Recent alluvium:			
Soil	0	18	18
Gravel	18	21	3
Columbia River basalt:			
"Rock, brown"	21	26	5
Basalt, dark, hard	26	71	45
Basalt, porous	71	85	14
Basalt, medium hard, and hard	85	120	35
Basalt, porous, with green clay	120	130	10
Basalt, soft, gray	130	143	13
Basalt, hard, black	143	147	4
Basalt, porous	147	158	11
Basalt, hard, gray and black, static water level at 208 feet is 11 feet	158	225	67
Basalt, porous	225	244	19
Basalt, porous, gray	244	270	26
Basalt, hard, gray and black	270	301	31
Basalt, porous, black	301	321	20
Basalt, hard	321	351	30
Basalt, porous	351	356	5
Shale, brown and blue	356	372	16
Basalt, alternating porous and hard	372	492	120
Basalt, porous, waterbearing	492	527	35
Basalt, hard, black	527	539	12
Basalt (no record of details)	539	1,200	661

UMAT

44/35-1576

Application No. U 218
Permit No. U 128
Well No. 2

Umatilla

REPORT ON COMPLETION OF WELL

(Note: This report should be submitted to the State Engineer, Salem, Oregon, as soon as possible after the well is completed. If more than one well is covered by this permit, a separate report shall be filed for each.)

Date of Report _____, 19____

1. Location of well: SW¹ of Section 15 Twp. 4N Rge. 35 E, W. M.
2. Name of nearest natural surface stream High Creek
3. Distance from well to that stream: 35 feet.
4. If the well is less than 1300 feet from a natural surface stream, give the difference in elevation between the ground surface at the well and the lowest point in stream channel: 15 feet.
5. Date of beginning of drilling or digging: For Eastern Ore. Road Co. - Mar 1, 1946
6. Date well was completed: For E. O. Road Co. - 4/27/46

Character of Material	Depth at which encountered	
	At surface	Below surface
		ft.
		ft.
		ft.
		ft.
		ft.
		ft.
		ft.
		ft.
		ft.
		ft.
		ft.
		ft.
		ft.

Remarks: _____

WELL INFORMATION

1. Diameter of well 15 x 12 x 8 inches. Depth of well 1218 feet.
2. Depth at which water was first encountered 21 feet.
3. Water level when completed: 64 feet below ground surface.
4. Additional information regarding well; such as soil conditions, quick sand, caves, obstructions, rock, etc.:
Surface water at 21' - see log

<u>Character of Material</u>	<u>Depth at which encountered At Surface</u>	<u>Thickness of stratum</u>
Top soil	0	18
Shallow surface water	18	3
Dark basalt	21	5
Dark basalt	26	27
Dark gray basalt	53	18
Dark porous basalt	71	14
Dark basalt	85	26
Dark gray basalt	111	110
Dark black basalt	221	4
Dark black basalt	225	20
Dark gray basalt	245	25
Dark gray basalt	270	2
Dark black basalt	272	16
Dark gray basalt	288	13
Dark porous basalt	301	20
Dark gray basalt - caving some	321	14
Dark black basalt	335	16
Dark black basalt	351	5
Brown and blue shale	356	16
Dark basalt	372	63
Dark black basalt	435	4
Dark basalt	439	2
Dark black basalt	441	39
Dark gray basalt	480	12
Dark basalt (Indications of water)	492	23
Dark gray basalt	515	92
Dark black basalt	607	41
Dark brown basalt, more water	648	6
Dark black basalt	654	98
Dark gray basalt	752	8
Dark black basalt	760	25
Dark gray basalt	785	10
Dark black basalt	795	65
Dark blue basalt	860	20
Dark blue basalt	880	10
Dark blue basalt	890	245
Dark blue basalt	1135	6
Dark blue basalt	1141	74
Dark formation - no samples	1215	3
Total depth		1218

PUMP INFORMATION

- 1. Manufacturer of pump: Fairbanks Morse & Co. - Pomona
- 2. Address: Pomona, California
- 3. Data on name or base plate: SP.F. 1007
- 4. Data on pump bowl assembly: 14 Stage 10" I.C.
- 5. Size of pump: 2" Std. column x 2-1/2" shaft. Water Lube
- 6. Rated capacity: 1000 GPM @ 250' - 700 Gallons per minute.
- 7. Rated speed: 1750 revolutions per minute.
- 8. Number of stages: 14
- 9. Size of intake pipe: 8"
- 10. Size of discharge pipe: 8"
- 11. Length of intake pipe: 5' plus screen
- 12. Length of discharge pipe: 15'
- 13. Suction lift: (difference in elevation between water surface in well and pump) 62'
- 14. Discharge lift: (difference in elevation between pump and end of discharge line) 21'
- 15. Depth of pump intake below ground surface: 345 feet.
- 16. Remarks: _____

MOTOR OR ENGINE INFORMATION

- 17. Name of manufacturer: General Electric
- 18. Address: _____
- 19. Type of motor or engine: Vertical hollow shaft squirrel cage induction motor, drip proof design
- 20. Data on name or base plate: G.E. Induction Motor Model 195727V
Frame N-6311-Type KF 44V.
Full load Amp 175 3 Phase 40 cycle
Full speed load 1775 RPM 180 HP
- 21. Rated horsepower: 150
- 22. Rated speed of motor or engine: 1750 revolutions per minute.

23. Rated Capacity of Pump (with described motor)

1100	G.P.M.	at	200	ft. head
1000	G.P.M.	at	250	ft. head
900	G.P.M.	at	300	ft. head
800	G.P.M.	at	350	ft. head
700	G.P.M.	at	400	ft. head

All discharge pressure 70 lbs.

24. Remarks: _____

CAPACITY TEST

41. Date of test: 3/16/32 37. Temperature of water 79 °F. or °C.
 42. Motor speed during test: 1760
 43. Well made by (weir, tank or other means): 8" dia. & 6" orifice

Pressure	TOTAL HEAD	Total lift in feet	Gallons per min.	Feet to water level	Draw-down	Time
1 lb.	Gauge at pump	Total 300 ft. in.	100	300 ft.	20 ft.	11 A.M.
2 lb.	Gauge at pump	Total 300 ft. in.	100	300 ft.	20 ft.	11 A.M.
* Difference in elevation between water level in well and outlet of pump test line. 2 feet
 * Distance from ground level to water surface in well. 64'
 * Distance water level is lowered during time interval. 325 Max.
 * Hour and minute at which observation was made. 12:15 PM

44. Installation will work efficiently under normal head of 300 ft.
 45. Water is discharged into: Cannery
 46. Was water lowered to pump intake by test? Yes
 47. Remarks: Recovery 138' in 120 seconds

GENERAL INFORMATION

48. Name of contractor or other party who drilled or dug well: A. A. DURAND & SON
P. O. Box 437. Address: Walla Walla, Washington
 49. Pump and motor were installed by: Same
 Address: _____
 50. Capacity test was made by: Same
 Address: _____
 51. General remarks: _____

