

UMAT  
2867

# Well Record

STATE WELL NO. 4N/29-17N(1)  
COUNTY Umatilla  
APPLICATION NO. U- 519

OWNER: Ben Dreyer


MAILING ADDRESS: Box 691

LOCATION OF WELL: Owner's No. 2

CITY AND STATE: Echo, Oregon

SW  $\frac{1}{4}$  SW  $\frac{1}{4}$  Sec. 17 T. 4 ~~SW~~ N. 29 ~~SW~~ E. W.M.

Bearing and distance from section or subdivision corner 1250' N. & 1240' E. from SW cor. sec. 17

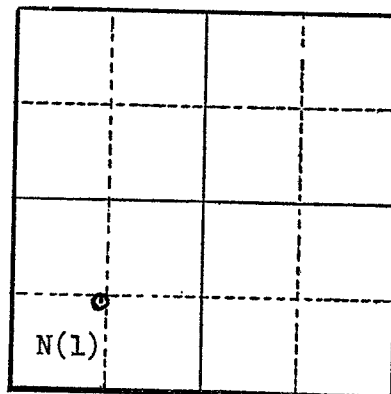

Section 17

Altitude at well

TYPE OF WELL: Drilled Date Constructed 1952

Depth drilled 245' Depth cased

CASING RECORD:  
12 inch

FINISH:

135 - 2" slots x 3/16" set from 150 to 200 feet

AQUIFERS:

Sand from 187 to 205 feet

WATER LEVEL:

90 feet in 1952 83.67 feet 1/24/61  
82 feet 11/17/58 84.90 feet 11/7/61

PUMPING EQUIPMENT: Type Washington vert. turbine (10 bowls) H.P. 50  
Capacity G.P.M.

WELL TESTS:

Drawdown 175 ft. after 600 hours G.P.M.  
intake set at 175'  
Drawdown ft. after hours G.P.M.

USE OF WATER Irrigation Temp. °F. 19

SOURCE OF INFORMATION Field visit U- 489

DRILLER or DIGGER Ben Dreyer

ADDITIONAL DATA:

Log  Water Level Measurements  Chemical Analysis  Aquifer Test

REMARKS:

