
NOTICE TO WATER WELL CONTRACTOR The original and first copy of this report are to be filed with the

STATE ENGINEER, SALEM, OREGON 97310 within 30 days from the date of well completion.

Duplicate WATER WELL REPORT

STATE OF OREGON

(Please type or print)
(Do not write above this line)

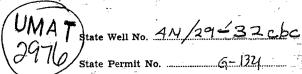

(1) OWNER: (11) LOCATION OF WELL: County Umatilla city of Stanfield Driller's well number City Well # Name T. 4N R. Stanfield, Oregon 1/2 Section 32 Bearing and distance from section or subdivision corner (2) TYPE OF WORK (check): Reconditioning [New Well Ki Deepening [Abandon □ If abandonment, describe material and procedure in Item 12. (3) TYPE OF WELL: (4) PROPOSED USE (check): 12-inch (12) WELL LOG: Diameter of well below casing Rotary Driven [ft. Depth of completed well 300 Domestic 🗌 Industrial 🗍 Municipal 🖵 Depth drilled 300 Cable Jetted | Irrigation | Test Well | Other Dug Bored [7 Formation: Describe color, texture, grain size and structure of materials; and show thickness and nature of each stratum and aquifer penetrated, CASING INSTALLED: Threaded | with at least one entry for each change of formation. Report each change in position of Static Water Level as drilling proceeds. Note drilling rates. 16 "Diam from 0 ft to 53 ft Gage 12 " Diam. from 0 ft. to ____ 70 MATERIAL Soil 0 Clay 2 **PERFORATIONS:** Perforated? | Yes K No. 47 Gravel 23 Type of perforator used 47 Shalev rock 53 in. by Size of perforations 53 Grav rock hard 87 perforations from ft. to ft. Rock brown soft (water) 87 90 perforations from _____ ft. to ____ ft. 90 95 Sand brown perforations from 126 95 Boulders green hard perforations from 126 144 Gray rock perforations from ... 144 150 Boulders Gray rock 150 205 (7) SCREENS: Well screen installed? ☐ Yes ☐ Ño Black rock 205 215 Manufacturer's Name Boulders 215 237 237 245 Red rock Diam. Slot size Set from 245 Boulders 267 Diam. Slot size Set from ft. to ft. 267 Black rock medium 275 (8) WATER LEVEL: Completed well. Gray Boulders hard ft. below land surface Date 7/9/59 Static level ian pressure lbs. per square inch Date Drawdown is amount water level is lowered below static level (9) WELL TESTS: Was a pump test made? ☐ Yes ☐ No If yes, by whom? Completed 7/9/59 Work started 5/21/59 Yield: 115 gal./min. with 230 ft. drawdown after 3 Date well drilling machine moved off of well ., . Drilling Machine Operator's Certification: This well was constructed under my direct supervision. Mateft. drawdown after Bailer test gal./min. with hrs. rials used and information reported above are true to my best knowledge and belief. Artesian flow g.p.m. Date Temperature of water Was a chemical analysis made? ☐ Yes ☐ No (Drilling Machine Operator) (10) CONSTRUCTION: Drilling Machine Operator's License No. Well seal-Material used Water Well Contractor's Certification: Depth of seal This well was drilled under my jurisdiction and this report is Diameter of well bore to bottom of seal true to the best of my knowledge and belief. Were any loose strata cemented off?

Yes

No Depth NAME Ben Dreyer Drilling Contractor Was a drive shoe used?
Yes No (Person, firm or corporation) (Type or print) Did any strata contain unusable water?

Yes

No Address Rt. 2 Box 73BB Pendleton, Oregon Type of water? depth of strata Method of sealing strata off (Water Well Contractor) Was well gravel packed? ☐ Yes ☐ No Size of gravel: Contractor's License No. 12 Date 7/10/59 , 19.....