

UMAT
3010

Well Record

STATE WELL NO. LN/30-35Q(1)
COUNTY Umatilla
APPLICATION NO. U- 558

OWNER: Leonard Lorenzen


MAILING
ADDRESS: _____

LOCATION OF WELL: Owner's No. _____

CITY AND
STATE: _____

SW $\frac{1}{4}$ SE $\frac{1}{4}$ Sec. 35 T. 4 ^{N.} ~~XX~~ 30 ^{E.} ~~XX~~ W.M.

Bearing and distance from section or subdivision
corner _____

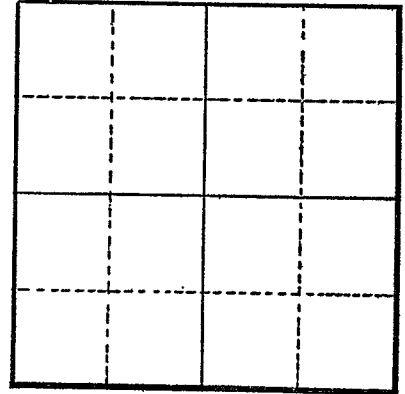

Section 35

Altitude at well _____

TYPE OF WELL: Drilled Date Constructed _____

Depth drilled 612' Depth cased _____

CASING RECORD:

6 5/8 inch

FINISH: _____

AQUIFERS: _____

WATER LEVEL:

88.5 feet on 11/20/58

PUMPING EQUIPMENT: Type _____ H.P. _____
Capacity _____ G.P.M.

WELL TESTS:

Drawdown _____ ft. after _____ hours _____ G.P.M.

Drawdown _____ ft. after _____ hours _____ G.P.M.

USE OF WATER Irrigation Temp. _____ °F. _____, 19____

SOURCE OF INFORMATION U- 506

DRILLER or DIGGER _____

ADDITIONAL DATA:

Log NA Water Level Measurements _____ Chemical Analysis _____ Aquifer Test _____

REMARKS: _____