

STATE ENGINEER
Salem, Oregon

UMAT
3030

Well Record

STATE WELL NO. 4N/33-2P.
COUNTY Umatilla
APPLICATION NO.

OWNER: George A. Mitchell


MAILING
ADDRESS:

LOCATION OF WELL: Owner's No.

CITY AND
STATE: Helix, Oregon

SE 1/4 SW 1/4 Sec. 2 T. 4 N. 33 E. W.M.

Bearing and distance from section or subdivision
corner

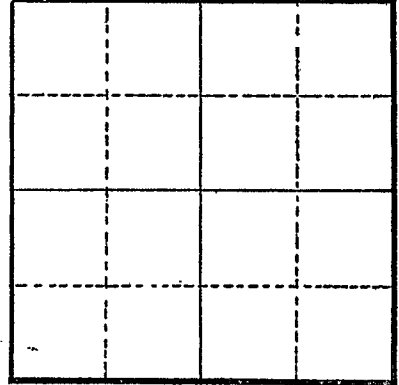

Section 2

Altitude at well 1758 ft.

TYPE OF WELL: Drilled Date Constructed 1956

Depth drilled 189 ft. Depth cased 102 ft.

CASING RECORD:
6 inch

FINISH:

AQUIFERS:

Little water at 70 ft.

WATER LEVEL:

129 ft.

PUMPING EQUIPMENT: Type Jacuzzi Jet H.P. 2

Capacity 15 G.P.M.

WELL TESTS:

Drawdown 40 ft. after 15 hours G.P.M.

Drawdown ft. after hours G.P.M.

USE OF WATER Irrigation Temp. °F., 19

SOURCE OF INFORMATION Related registration statement

DRILLER or DIGGER Moore & Andersen

ADDITIONAL DATA:

Log Water Level Measurements Chemical Analysis Aquifer Test

REMARKS: