

STATE ENGINEER  
Salem, Oregon

UMAT  
304

# Well Record

STATE WELL NO. 1N/32-15E(1)  
COUNTY Umatilla  
APPLICATION NO. G- 262

OWNER: William Eldridge


MAILING  
ADDRESS: \_\_\_\_\_

LOCATION OF WELL: Owner's No. \_\_\_\_\_

CITY AND  
STATE: Pilot Rock, Oregon

SW ¼ NW ¼ Sec. 15 T. 1 ~~XXX~~R. 32 ~~XXX~~E. W.M.

Bearing and distance from section or subdivision  
corner N.16°49'20"E. 4042.8' from SW cor. sec. 15

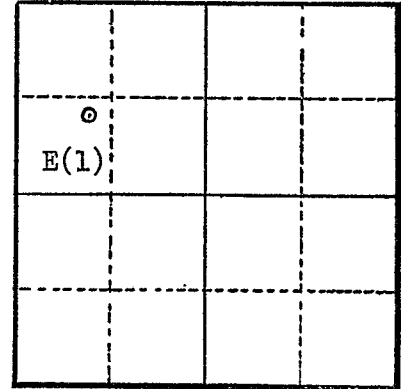

Section 15

Altitude at well \_\_\_\_\_

TYPE OF WELL: Drilled Date Constructed 12/55-2/56

Depth drilled 284' Depth cased 24'

CASING RECORD:

12 inch

FINISH:

AQUIFERS:

Basalt

WATER LEVEL:

12 feet (Feb. 1956)

PUMPING EQUIPMENT: Type \_\_\_\_\_

H.P. \_\_\_\_\_

Capacity \_\_\_\_\_ G.P.M.

WELL TESTS:

Drawdown 5 ft. after 6 hours 320 G.P.M.

Drawdown \_\_\_\_\_ ft. after \_\_\_\_\_ hours \_\_\_\_\_ G.P.M.

USE OF WATER Irrigation Temp. 50 °F. Feb., 19 56

SOURCE OF INFORMATION Drillers report G- 185

DRILLER or DIGGER French Drilling Co.

ADDITIONAL DATA:

Log  Water Level Measurements \_\_\_\_\_ Chemical Analysis \_\_\_\_\_ Aquifer Test \_\_\_\_\_

REMARKS:

