

STATE ENGINEER
Salem, Oregon

UMAT
3059

Well Record


STATE WELL NO. LN/34-32N(1)
COUNTY Umatilla
APPLICATION NO. U-739

OWNER: L. L. Rogers Estate MAILING ADDRESS: 311 N. Main St.

LOCATION OF WELL: Owner's No. Greasewood #3 CITY AND STATE: Pendleton, Oregon

SW 1/4 SW 1/4 Sec. 32 T. 4 N. 34 E. W.M.

Bearing and distance from section or subdivision corner N.19°16'30"E. 958.4' from SW cor. sec. 32

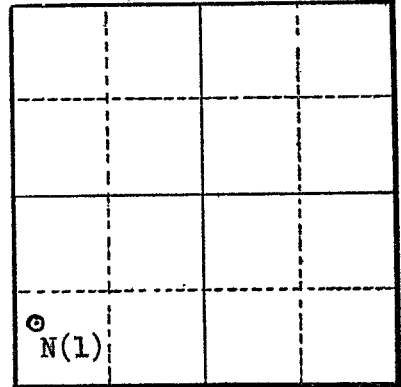

Section 32

Altitude at well _____

TYPE OF WELL: Drilled Date Constructed 1953

Depth drilled 451' Depth cased _____

CASING RECORD:
8 inch

FINISH:

AQUIFERS:

WATER LEVEL:
40 feet on 5/15/57
30 feet on 10/2/57

PUMPING EQUIPMENT: Type Jacuzzi, 4" turbine H.P. 20
Capacity 120 G.P.M.

WELL TESTS:
Drawdown 315 ft. after 8/20/55 hours 315 G.P.M.
Drawdown 315 ft. after 8/15/57 hours 315 G.P.M.

USE OF WATER Irrigation (30.8 acres) Temp. _____ °F., 19

SOURCE OF INFORMATION U-678
DRILLER or DIGGER Ben Dreyer

ADDITIONAL DATA:
Log X Water Level Measurements _____ Chemical Analysis _____ Aquifer Test _____

REMARKS:

Application U-739
Permit U678

COPY OF LOG OF WELL, Greasewood #3, furnished by Ben Dreyer,
contracting driller.

Well started June 27, 1953
Well finished September 9, 1953

368 feet of 8" pipe

From	to	
0	6	Sandy soil
6	36	Rock, black and hard
36	69	Loose boulders
69	80	Rock, red and hard
80	85	Sand and boulders
85	92	Rock, red and soft
92	120	Rock blue and hard
120	160	Rock, black and medium
160	192	Blue and hard
192	250	Rock, black and medium
250	256	Sand and boulders
256	268	Red and soft
268	288	Rock, red and medium
288	335	Rock blue and medium
335	368	Sand and boulders
368	412	Rock, black and medium
412	421	Rock, black and hard
421	428	Rock, black and medium
428	434	Green shale
434	451	Boulders and sand

Well tested 85 gal. per min.