

STATE ENGINEER
Salem, Oregon

UMAT
321

Well Record

STATE WELL NO. 1N/32-22B(1)
COUNTY Umatilla
APPLICATION NO.

OWNER: J.L. Eldridge


MAILING
ADDRESS:

LOCATION OF WELL: Owner's No.

CITY AND
STATE:

NW ¼ NE ¼ Sec. 22 T. 1 N. 32 E.
S., R. W., W.M.

Bearing and distance from section or subdivision
corner

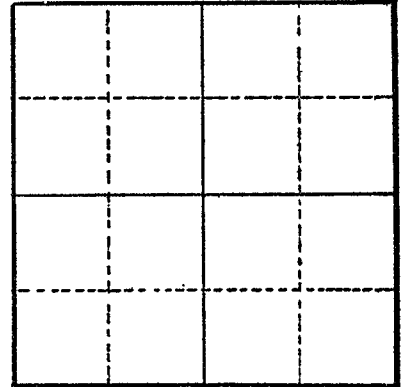

Section

Altitude at well 1,4000

TYPE OF WELL: Drilled Date Constructed

Depth drilled 406 ft. Depth cased 20 ft.

CASING RECORD: 10 inches

FINISH:

AQUIFERS: Basalt

WATER LEVEL: 20 feet below land surface,

PUMPING EQUIPMENT: Type Turbine H.P.
Capacity 500 G.P.M.

WELL TESTS:
Drawdown 5.2 ft. after ¼ hours 400 G.P.M.
Drawdown ft. after hours G.P.M.

USE OF WATER Irrigation Temp. °F., 19.....

SOURCE OF INFORMATION

DRILLER or DIGGER

ADDITIONAL DATA:

Log Water Level Measurements Chemical Analysis Aquifer Test

REMARKS:

