

STATE ENGINEER  
Salem, Oregon

UMAT  
322

OBSERVATION WELL  
Well Record

STATE WELL NO. 1N/32-22G(1)  
COUNTY Umatilla  
APPLICATION NO.

OWNER: J. L. Eldridge


MAILING ADDRESS:

LOCATION OF WELL: Owner's No.

CITY AND STATE:

SW 1/4 NE 1/4 Sec. 22 T. 1 N. 32 E. S., R. W., W.M.

Bearing and distance from section or subdivision corner

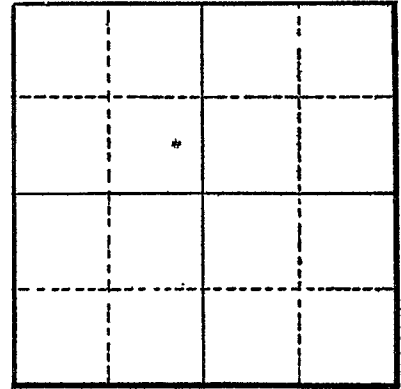

Section

Altitude at well 1,400

TYPE OF WELL: Drilled Date Constructed

Depth drilled 220.540 Depth cased 30 ft.

CASING RECORD: 12 inches, 30 ft.

FINISH:

AQUIFERS:

WATER LEVEL: 10.12 feet below land surface, July 17, 1952.

PUMPING EQUIPMENT: Type H.P. Capacity G.P.M.

WELL TESTS: Drawdown ft. after hours G.P.M. Drawdown ft. after hours G.P.M.

USE OF WATER Irrigation Temp. °F., 19

SOURCE OF INFORMATION

DRILLER or DIGGER

ADDITIONAL DATA: Log Water Level Measurements Chemical Analysis Aquifer Test

REMARKS: