

STATE ENGINEER
Salem, Oregon

UMAT
3338

Well Record

STATE WELL NO. 5N/28-10R(2)
COUNTY Umatilla
APPLICATION NO. G- 694

OWNER: U.S. Army corps of Engineers


MAILING ADDRESS: McNary Dam

LOCATION OF WELL: Owner's No. #2

CITY AND STATE: _____

SE 1/4 SE 1/4 Sec. 10 T. 5 N. XX, R. 28 E. XX W.M.

Bearing and distance from section or subdivision corner 1132' N. & 1250' W. of SE cor. of sec. 10

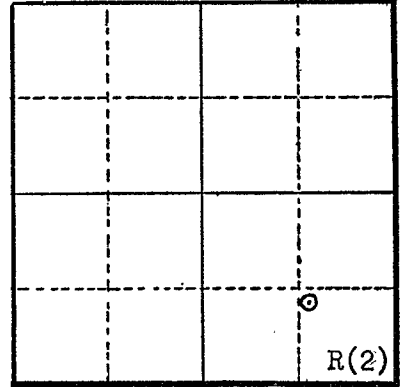

Section 10

Altitude at well 373'

TYPE OF WELL: Drilled Date Constructed 7/15/48

Depth drilled 702' Depth cased 323'

CASING RECORD:

- 20 inch from 0 to 118 feet
- 16 inch from 118 to 323 feet
- 12 inch open hole from 323 to 702 feet

FINISH:

AQUIFERS:

Basalt

WATER LEVEL:

- 105 feet (1948)
- 124 feet (11/13/58)

PUMPING EQUIPMENT: Type 10" turbine H.P. 200

Capacity _____ G.P.M.

WELL TESTS:

- Drawdown _____ ft. after _____ hours _____ G.P.M.
- Drawdown _____ ft. after _____ hours _____ G.P.M.

USE OF WATER Industrial Temp. _____ °F. _____, 19____

SOURCE OF INFORMATION G- 642

DRILLER or DIGGER _____

ADDITIONAL DATA:

Log NA Water Level Measurements _____ Chemical Analysis _____ Aquifer Test _____

REMARKS: