

STATE ENGINEER
Salem, Oregon

UMAT
3400

OBSERVATION WELL

Well Record

STATE WELL NO. 50/28-22 D(1)
COUNTY UHATILLA
APPLICATION NO. 11-290

OWNER: L. J. MARTIN (MUNSON Auto G.) MAILING ADDRESS: HERMISTON

LOCATION OF WELL: Owner's No. _____ CITY AND STATE: _____

NW 1/4 NW 1/4 Sec. 22 T. 5 N. S. R. 28 E. W. W.M.


Bearing and distance from section or subdivision

corner _____

Altitude at well 450'

TYPE OF WELL: DRILLED Date Constructed 7-2-48

Depth drilled 170' Depth cased 8'

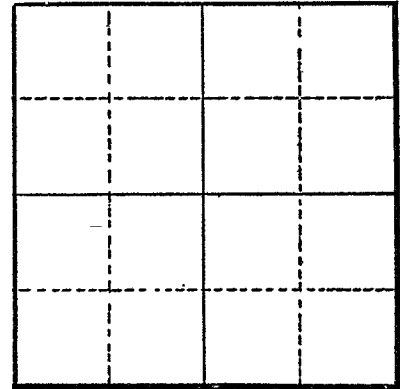

Section 22

CASING RECORD:

6 INCH

FINISH:

AQUIFERS:

BASALT

WATER LEVEL:

6.02 (1-18-55)

PUMPING EQUIPMENT: Type MEYERS H.P. 1/4
Capacity _____ G.P.M.

WELL TESTS:

Drawdown _____ ft. after _____ hours _____ G.P.M.

Drawdown _____ ft. after _____ hours _____ G.P.M.

USE OF WATER DOMESTIC Temp. _____ °F. _____, 19.

SOURCE OF INFORMATION 11-290

DRILLER or DIGGER TROY GRIFFIN

ADDITIONAL DATA:

Log ☒ Water Level Measurements ☒ Chemical Analysis _____ Aquifer Test _____

REMARKS: TOP SOIL 0 TO 2'
HARD PAN 2' TO 8'
ROCK 8' TO 155'
SHALE 155' TO 170'