

STATE ENGINEER
Salem, Oregon

UMAT
3621

Well Record

STATE WELL NO. 5N/28-35P(1)
COUNTY Umatilla
APPLICATION NO. G-199

OWNER: Ruby V. Welch


MAILING ADDRESS: Rt. 2 Box 13A

LOCATION OF WELL: Owner's No. _____

CITY AND STATE: Hermiston, Oregon

SE 1/4 SW 1/4 Sec. 35 T. 5 N. 28 E. W, W.M.

Bearing and distance from section or subdivision corner 2115' E. & 135' N. of SW cor. sec. 35
Field survey: 228' N. & 525' W. from S 1/4 cor of sec. 35.

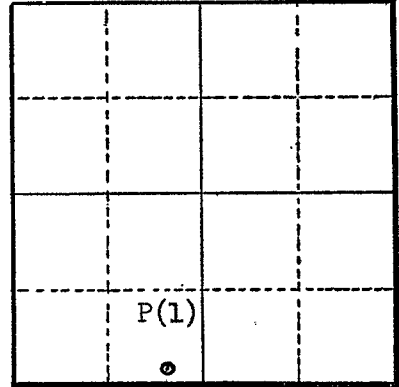

Section 35

Altitude at well _____

TYPE OF WELL: Drilled Date Constructed Sept-Oct. '55

Depth drilled 178' Depth cased 168'

CASING RECORD:
6 inch

FINISH: _____

AQUIFERS: _____

WATER LEVEL:
92 feet

PUMPING EQUIPMENT: Type Worthington turbine H.P. 10
Capacity _____ G.P.M.

WELL TESTS:
Drawdown 78 ft. after 4 hours 125 G.P.M.
Drawdown _____ ft. after _____ hours _____ G.P.M.

USE OF WATER Irrigation Temp. 62 °F. October, 1955
SOURCE OF INFORMATION Drillers report G-110
DRILLER or DIGGER W.R. Ille & Co.

ADDITIONAL DATA:
Log X Water Level Measurements _____ Chemical Analysis _____ Aquifer Test _____

REMARKS:
Sand 0 to 50
Sand & gravel 50 to 168
Basalt, broken 168 to 178