

NOTICE TO WATER WELL CONTRACTOR

The original and first copy of this report are to be filed with the

WATER WELL REPORT

STATE OF OREGON

(Please type or print) Do not write above this line

STATE ENGINEER, SALEM, OREGON 97310 within 30 days from the date of well completion.

UMAT 3894

State Well No. 5N/35-1

State Permit No.

(1) OWNER:

Name Thomas A. Schroeder
Address P. O. Box 195
Milton-Freewater, Oregon

(2) TYPE OF WORK (check):

New Well [X] Deepening [] Reconditioning [] Abandon []

If abandonment, describe material and procedure in Item 12.

(3) TYPE OF WELL:

Rotary [] Driven []
Cable [X] Jetted []
Dug [] Bored []

(4) PROPOSED USE (check):

Domestic [] Industrial [] Municipal []
Irrigation [X] Test Well [] Other []

CASING INSTALLED:

6" Diam. from 0 ft. to 30 ft. Gage 250
Threaded [] Welded [X]

PERFORATIONS:

Perforated? [] Yes [X] No
Type of perforator used
Size of perforations in. by in.
perforations from ft. to ft.

(7) SCREENS:

Well screen installed? [] Yes [X] No
Manufacturer's Name
Type Model No.
Diam. Slot size Set from ft. to ft.

(8) WATER LEVEL: Completed well.

Static level 9 ft. below land surface Date 6/30/69
Artesian pressure lbs. per square inch Date

(9) WELL TESTS:

Drawdown is amount water level is lowered below static level
Was a pump test made? [X] Yes [] No If yes, by whom? Driller
Yield: 25 gal./min. with 2 ft. drawdown after 1 hrs.
Bailer test gal./min. with ft. drawdown after hrs.
Artesian flow g.p.m. Date
Temperature of water 48 Was a chemical analysis made? [] Yes [X] No

(10) CONSTRUCTION:

Well seal—Material used Puddled clay
Depth of seal 18 ft.
Diameter of well bore to bottom of seal 10 in.
Were any loose strata cemented off? [] Yes [X] No Depth
Was a drive shoe used? [X] Yes [] No
Did any strata contain unusable water? [] Yes [X] No
Type of water? depth of strata
Method of sealing strata off
Was well gravel packed? [] Yes [X] No Size of gravel:
Gravel placed from ft. to ft.

(11) LOCATION OF WELL:

County Umatilla Driller's well number
1/4 1/4 Section 1 T. 5 R. 35 E. W.M.
Bearing and distance from section or subdivision corner

(12) WELL LOG:

Diameter of well below casing 6"
Depth drilled 51 ft. Depth of completed well 51 ft.

Formation: Describe color, texture, grain size and structure of materials; and show thickness and nature of each stratum and aquifer penetrated, with at least one entry for each change of formation. Report each change in position of Static Water Level as drilling proceeds. Note drilling rates.

Table with columns: MATERIAL, From, To, SWL. Rows include Gray clay & fine sand, Gray clay & sm. boulders, Fine gravel, Coarse gravel & sm. bould., Tan clay, Coarse gravel.

Work started 6/26 1969 Completed 6/30 1969
Date well drilling machine moved off of well 7/1 1969

Drilling Machine Operator's Certification:

This well was constructed under my direct supervision. Materials used and information reported above are true to my best knowledge and belief.

[Signed] E.M.J. Behrens Date 7/9, 1969
(Drilling Machine Operator)

Drilling Machine Operator's License No. 124

Water Well Contractor's Certification:

This well was drilled under my jurisdiction and this report is true to the best of my knowledge and belief.

NAME E. M. J. Behrens
(Person, firm or corporation) (Type or print)

Address P.O. Box 201-Milton-Freewater, Oreg.

[Signed] E.M.J. Behrens
(Water Well Contractor)

Contractor's License No. 229 Date 7/9, 1969

		Well No	Depth	Log Available		Drilled
Milton Frazar	# 1	12F1	651	✓	✓	Durand 1937-38
	# 2	12F2	902	✓	✓	Durand 1944
	# 3	2J1	550	✓	✓	Scott 1946
	# 4	2H1	374	No		?
	# 5	2E2	502	✓	✓	Durand 1936
	# 6	2L1	952	✓	✓	Scott 1950
(Utah Comm Co)	# 7	2E11	528	✓	✓	Durand 1944-45
	# 8	1FM1				Skinner 1963
Rugas	# 1	12G1	702	✓	✓	Durand 1944
Rugas	# 2	12G2	560	✓		Scott 1951
Umetille	# 1	12Q1	918	✓		Durand 1951

Log in
with
RPT


MILTON - FREEWATER

Scale in Feet



UMATILLA COUNTY

RECEIVED
APR 8 1955
STATE ENGINEER
SALEM, OREGON

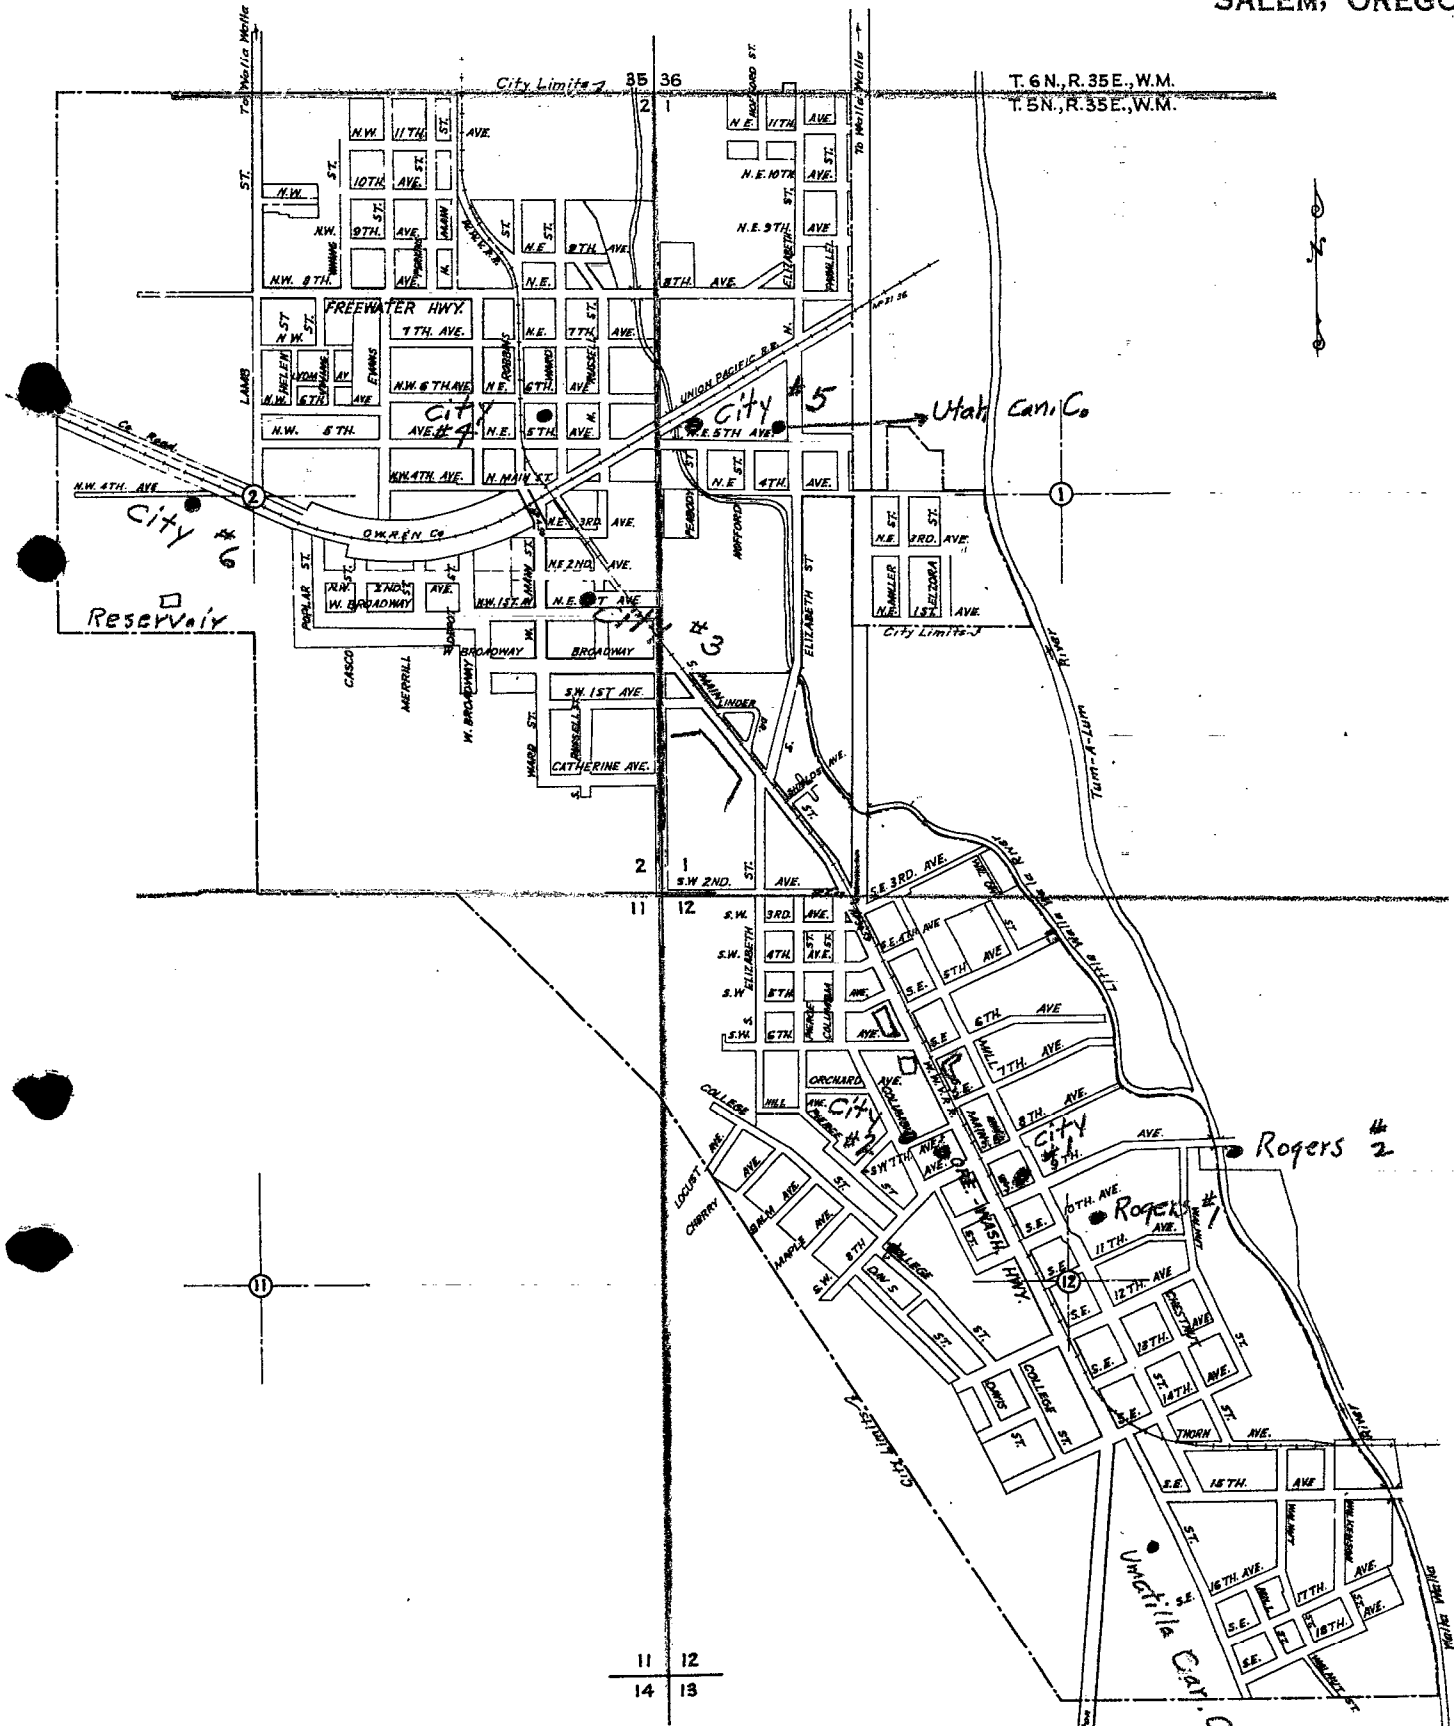

Location of Wells in City.

U-807