

STATE ENGINEER
Salem, Oregon

UMAT
3911

Well Record

GR- 1101

STATE WELL NO. 5N/35-1D.3
COUNTY Umatilla
APPLICATION NO. GR- 1141

OWNER: O. W. Obert

MAILING
ADDRESS:

RT. 1, Box 184

LOCATION OF WELL: Owner's No.


CITY AND
STATE:

Milton-Freewater, Oregon

N. E.
NW ¼ NW ¼ Sec. 1 T. 5 R. 35 W., W.M.

Bearing and distance from section or subdivision

corner 990' S. & 860' E. from NW cor. Sec. 1.

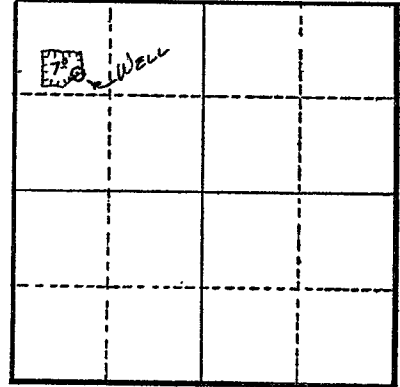

Section 1

Altitude at well 1000 ft.

TYPE OF WELL: Dug Date Constructed 1920

Depth drilled 20 ft. Depth cased 12 ft.

CASING RECORD:

4' x 4' Concrete curb from 0 to 12 ft.

FINISH:

AQUIFERS:

WATER LEVEL:

14 ft.

PUMPING EQUIPMENT: Type Cent. 2½ x 2½ in.

H.P. 5

Capacity 150 G.P.M.

WELL TESTS:

Drawdown ft. after hours G.P.M.

Drawdown ft. after hours G.P.M.

USE OF WATER Irrigation Temp. °F. 19

SOURCE OF INFORMATION G. R. Record

DRILLER or DIGGER

ADDITIONAL DATA:

Log N. A. Water Level Measurements Chemical Analysis Aquifer Test

REMARKS:

Irrigation of 7 acres.