

STATE ENGINEER
Salem, Oregon

UMAT
3916

Well Record

STATE WELL NO. 5N/35-1F
COUNTY Umatilla
APPLICATION NO. GR-1242

GR- 1200

OWNER: Orval Mason


MAILING ADDRESS: Rt. 1, Box 225

LOCATION OF WELL: Owner's No.

CITY AND STATE: Milton-Freewater, Oregon

SE 1/4 NW 1/4 Sec. 1 T. 5 N. 35 E. W.M.

Bearing and distance from section or subdivision
corner 724' E. & 20' N. from SW cor. SE 1/4 NW 1/4 of
Section 1.

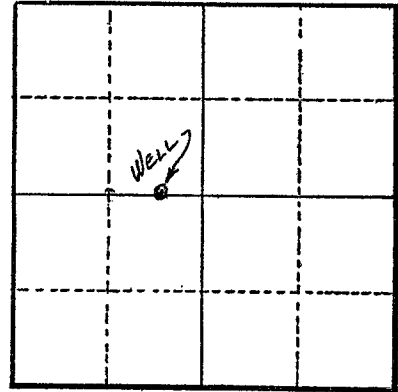

Section 1

Altitude at well

TYPE OF WELL: Dug Date Constructed 1926

Depth drilled 24 ft. Depth cased 11 ft.

CASING RECORD:

6 x 6 ft. concrete from 0 to 11 ft.

FINISH:

AQUIFERS:

WATER LEVEL:

11 ft.

PUMPING EQUIPMENT: Type 2 1/2 in. Cent. H.P. 3

Capacity 200 G.P.M.

WELL TESTS:

Drawdown 22 ft. after 200 hours G.P.M.

Drawdown ft. after hours G.P.M.

USE OF WATER Irrigation Temp. °F. 19

SOURCE OF INFORMATION G. R. Record

DRILLER or DIGGER

ADDITIONAL DATA:

Log N.A. Water Level Measurements Chemical Analysis Aquifer Test

REMARKS:

Irrigation of 4 acres.