

STATE ENGINEER  
Salem, Oregon

UMAT  
3931

# Well Record

STATE WELL NO. 5N/35-2D(1)  
COUNTY Umatilla  
APPLICATION NO. GR-3856

OWNER: Gust Seibold


MAILING ADDRESS: \_\_\_\_\_

LOCATION OF WELL: Owner's No. \_\_\_\_\_

CITY AND STATE: Milton-Freewater, Oregon

NW  $\frac{1}{4}$  NW  $\frac{1}{4}$  Sec. 2 T. 5 N. 35 E. W, W.M.

Bearing and distance from section or subdivision corner \_\_\_\_\_

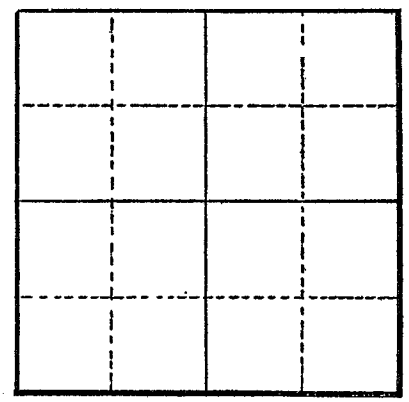

Section 2

Altitude at well 950'

TYPE OF WELL: Drilled Date Constructed 1946

Depth drilled 344' Depth cased 100'

CASING RECORD:  
° 8 inch set from 12 to 100 feet  
6 inch open hole below 150 feet

FINISH: \_\_\_\_\_

AQUIFERS:  
Basalt

WATER LEVEL:  
53 feet (March 1946)

PUMPING EQUIPMENT: Type Turbine H.P. \_\_\_\_\_  
Capacity 150 G.P.M.

WELL TESTS:  
Drawdown \_\_\_\_\_ ft. after \_\_\_\_\_ hours \_\_\_\_\_ G.P.M.  
Drawdown \_\_\_\_\_ ft. after \_\_\_\_\_ hours \_\_\_\_\_ G.P.M.

USE OF WATER Irrigation Temp. \_\_\_\_\_ °F. \_\_\_\_\_, 19\_\_\_\_

SOURCE OF INFORMATION USGS GR-3512

DRILLER or DIGGER A.A. Durand & Son

ADDITIONAL DATA:  
Log  Water Level Measurements \_\_\_\_\_ Chemical Analysis \_\_\_\_\_ Aquifer Test \_\_\_\_\_

REMARKS:

- Dug well, no record 0 to 28
- Gravel, coarse, loose 28 to 95
- Basalt, black 95 to 105
- Basalt, brown, porous 105 to 150
- Basalt, black, creviced 189-190 & 214-218 ---- 150 to 253
- Basalt, porous 253 to 292
- Basalt, firm, black 292 to 308
- Basalt, red 308 to 331
- Basalt, black 331 to 344