

STATE ENGINEER
Salem, Oregon


UMAT
3936

Well Record

STATE WELL NO. 5N/35-2D
COUNTY UMATILLA
APPLICATION NO. GR-2647

OWNER: Louis Eggebrecht & Donald Eggebrecht
MAILING ADDRESS: Rt. 2, Box 367
CITY AND STATE: Milton-Freewater, Oregon

LOCATION OF WELL: Owner's No. _____
N. E. R. 35 W. W.M.
NW 1/4 NW 1/4 Sec. 2 T. 5 S. R. 35 W. W.M.
Bearing and distance from section or subdivision corner
Approx. 160' S. from a point 17' W.

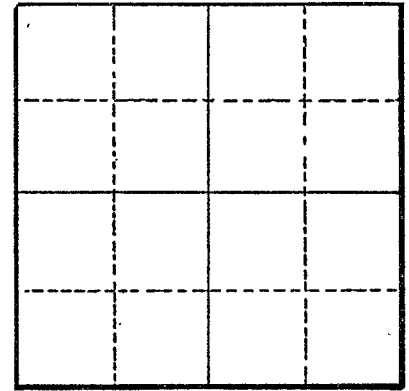

Section _____

Altitude at well _____

TYPE OF WELL: Dug & _____ Date Constructed 1923
Depth drilled 55 Drilled Depth cased 29

CASING RECORD:

6-inch

FINISH:

AQUIFERS:

Topsoil, gravel and cement curb.

WATER LEVEL:

26-feet

PUMPING EQUIPMENT: Type Centrifugal H.P. 3
Capacity _____ G.P.M.

WELL TESTS:

Drawdown 21 ft. after _____ hours Pumping 200 G.P.M.
Drawdown _____ ft. after _____ hours _____ G.P.M.

USE OF WATER Irrigation Temp. _____ °F. _____, 19

SOURCE OF INFORMATION GR-2509

DRILLER or DIGGER Earl Shortridge, Rt. 3, Milton-Freewater, Oregon

ADDITIONAL DATA:

Log Water Level Measurements _____ Chemical Analysis _____ Aquifer Test _____

REMARKS:

2' Topsoil, Gravel 53'
5' x 5 1/2' Cement curb, 21' depth