

UMAT
3937


Well Record

OWNER: Gust Seibold MAILING ADDRESS: Route 2, Box 570

LOCATION OF WELL: Owner's No. _____ CITY AND STATE: Milton-Freewater, Oregon

NW ¼ NW ¼ Sec. 2 T. 5 N. 35 E. W, W.M.

Bearing and distance from section or subdivision corner 1300' E. & 1305' S. of NW cor. Sec. 2

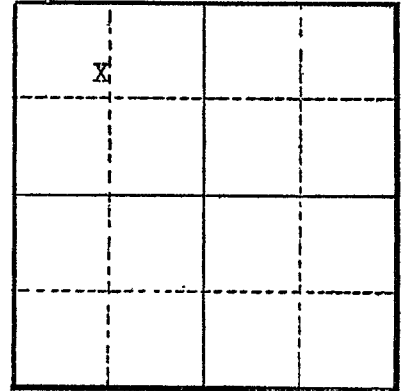

Section 2

Altitude at well _____

TYPE OF WELL: ^{Dug} Drilled Date Constructed 1918

Depth drilled 344 ft. Depth cased 61 ft.

CASING RECORD:

8 inch standard pipe casing set from 12 to 61 feet

FINISH:

AQUIFERS:

WATER LEVEL:

95 feet below surface

PUMPING EQUIPMENT: Type Fairbanks Morse H.P. 10
Capacity 400 G.P.M.

WELL TESTS:

Drawdown _____ ft. after _____ hours _____ G.P.M.

Drawdown _____ ft. after _____ hours _____ G.P.M.

USE OF WATER Irrigation Temp. _____ °F. _____, 19____

SOURCE OF INFORMATION Well Registration Statement-Cert. # GR-3512

DRILLER or DIGGER _____

ADDITIONAL DATA:

Log X Water Level Measurements _____ Chemical Analysis _____ Aquifer Test _____

REMARKS:

