

STATE ENGINEER
Salem, Oregon

UMAT
3946

Well Record

STATE WELL NO. 5N/35-3
COUNTY UMATILLA
APPLICATION NO. GR-2744

OWNER: Cecil & Ruth Carter


MAILING ADDRESS: Rt. 2, Box 27

LOCATION OF WELL: Owner's No.

CITY AND STATE: Milton-Freewater, Oregon

NW ¹/₄ NW ¹/₄ NE ¹/₄ Sec. 3 T. 5 ^{N.N} S.R. 35 ^{E.} W, W.M.

Bearing and distance from section or subdivision corner 288' S. and 655' E.

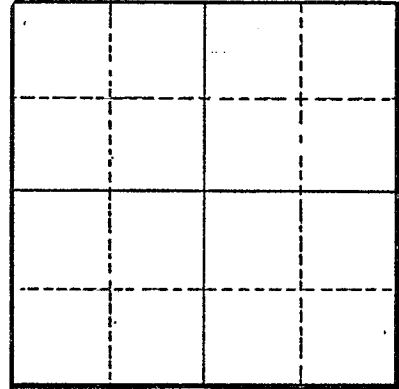

Section

Altitude at well

TYPE OF WELL: dug Date Constructed 1908

Depth drilled 30 Depth cased 12

CASING RECORD:

6-square feet

FINISH:

AQUIFERS:

WATER LEVEL:

20-feet

PUMPING EQUIPMENT: Type Pacific Centrifugal H.P. 3
Capacity 250 G.P.M.

WELL TESTS:

Drawdown ft. after hours G.P.M.
Drawdown ft. after hours G.P.M.

USE OF WATER irrigation Temp. °F. 19

SOURCE OF INFORMATION GR-2596

DRILLER or DIGGER George A. Hardy (deceased)

ADDITIONAL DATA:

Log Water Level Measurements Chemical Analysis Aquifer Test

REMARKS: