

STATE ENGINEER  
Salem, Oregon

UMAT  
3947

# Well Record

STATE WELL NO. 5N/35-3F(1)  
COUNTY Umatilla  
APPLICATION NO. U-401

OWNER: P. S. Gibbons Jr. MAILING ADDRESS: Rt. 2 Box 34

LOCATION OF WELL: Owner's No. CITY AND STATE: Milton-Freewater, Oregon


SE 1/4 NW 1/4 Sec. 3 T. 5 N. 35 E. W.M.

Bearing and distance from section or subdivision corner

Altitude at well

TYPE OF WELL: Drilled Date Constructed 1949-54

Depth drilled 190' Depth cased 65'

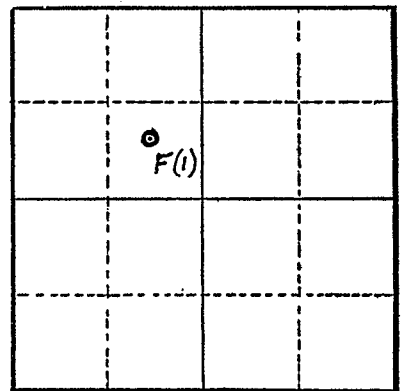

Section 3

CASING RECORD:  
10 inch

FINISH:

AQUIFERS:  
Basalt

WATER LEVEL:  
45 feet in 1954  
54.4 feet (pump off 5 min.) 8/7/57

PUMPING EQUIPMENT: Type Turbine H.P. 10  
Capacity G.P.M.

WELL TESTS:  
Drawdown 4 ft. after 210 hours G.P.M.  
Drawdown ft. after hours G.P.M.

USE OF WATER Irrigation Temp. °F. 19

SOURCE OF INFORMATION U-365  
DRILLER or DIGGER Heitstumon Bros.

ADDITIONAL DATA:  
Log Water Level Measurements Chemical Analysis Aquifer Test

REMARKS:  
Well listed as 3C(1) in USGS report.

