

STATE ENGINEER  
Salem, Oregon

UMAT  
3948

# Well Record


STATE WELL NO. 5N/35-3D  
COUNTY UMATILLA  
APPLICATION NO. GR-2557

OWNER: Franklin J. Wollenschlaeger MAILING ADDRESS: Rt. 2, Box 30

LOCATION OF WELL: Owner's No. CITY AND STATE: Milton-Freewater, Oregon

NW 1/4 NW 1/4 Sec. 3 T. 5 N. S, R. 35 E. W.M.

Bearing and distance from section or subdivision corner 20' S. & 29' W.

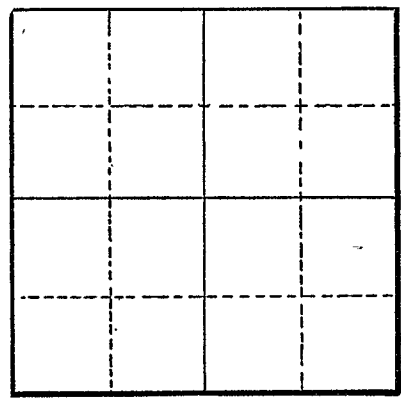

Section

Altitude at well

TYPE OF WELL: Dug Date Constructed 1904 Prior

Depth drilled 31 Depth cased 15

### CASING RECORD:

60 x 72-inch

### FINISH:

### AQUIFERS:

Topsoil and gravel

### WATER LEVEL:

10-feet

PUMPING EQUIPMENT: Type Centrifugal H.P. 3  
Capacity 300 G.P.M.

### WELL TESTS:

Drawdown 15 ft. after hours Pumping 300 G.P.M.  
Drawdown ft. after hours G.P.M.

USE OF WATER Irrigation Temp. °F., 19

SOURCE OF INFORMATION GR-2416

DRILLER or DIGGER

### ADDITIONAL DATA:

Log X Water Level Measurements Chemical Analysis Aquifer Test

### REMARKS:

Topsoil gravelly 2 2  
Cement gravel 29 31