

STATE ENGINEER
Salem, Oregon

UMAT
3957

Well Record

STATE WELL NO. 5N/35-5C(1)
COUNTY Umatilla
APPLICATION NO. U-348

OWNER: Nellie M. Murry MAILING ADDRESS: 608 N. Main

LOCATION OF WELL: Owner's No. 1 CITY AND STATE: Milton-Freewater, Oregon


NE 1/4 NW 1/4 Sec. 5 T. 5 ~~SW~~ N. 35 ~~W~~ E. W.M.

Bearing and distance from section or subdivision corner

Altitude at well

TYPE OF WELL: Drilled Date Constructed 1949

Depth drilled 245' Depth cased

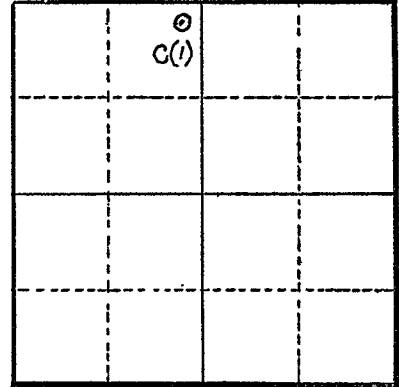

CASING RECORD:
8 inch

FINISH:

AQUIFERS:
Basalt & gravel

WATER LEVEL:
80 feet in 1949

PUMPING EQUIPMENT: Type Peerless turbine H.P. 15
Capacity 150 G.P.M.

WELL TESTS:
Drawdown 70 ft. after _____ hours 150 G.P.M.
Drawdown _____ ft. after _____ hours _____ G.P.M.

USE OF WATER Irrigation & domestic Temp. _____ °F. _____, 19____

SOURCE OF INFORMATION U-323

DRILLER or DIGGER Heitstuman Bros.

ADDITIONAL DATA:
Log Water Level Measurements _____ Chemical Analysis _____ Aquifer Test _____

REMARKS:
Soil 0 to 3
Gravel, loose 3 to 18
Clay & gravel 18 to 30
Cemented gravel 30 to 60
Clay 60 to 130
Basalt 130 to 245