

STATE ENGINEER
Salem, Oregon

UMAT 3992

Well Record

STATE WELL NO. 5N/36-9D1
COUNTY UMATILLA
APPLICATION NO.

OWNER: G. S. Cockburn

MAILING ADDRESS:


LOCATION OF WELL: Owner's No.

CITY AND STATE:

1/4 1/4 Sec. T. N. S., R. E. W., W.M.

Bearing and distance from section or subdivision

corner

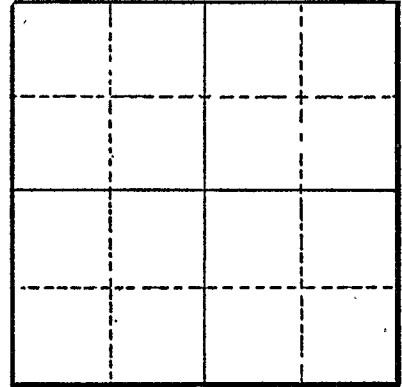

Section

Altitude at well 1,220

TYPE OF WELL: Drilled Date Constructed

Depth drilled 400 Depth cased

CASING RECORD:

6 inch

FINISH:

AQUIFERS:

Basalt

WATER LEVEL:

380? feet below land surface, 1948

PUMPING EQUIPMENT: Type Plunger

H.P.

Capacity G.P.M.

WELL TESTS:

Drawdown ft. after hours G.P.M.

Drawdown ft. after hours G.P.M.

USE OF WATER Domestic, stock

Temp. °F., 19

SOURCE OF INFORMATION USGS

DRILLER or DIGGER

ADDITIONAL DATA:

Log Water Level Measurements Chemical Analysis Aquifer Test

REMARKS: