

UMAT
4091

Well Record

OWNER: O. L. Heilberg


MAILING ADDRESS:

LOCATION OF WELL: Owner's No.

CITY AND STATE:

..... 1/4 1/4 Sec. T. N. E. S., R. W., W.M.

Bearing and distance from section or subdivision corner

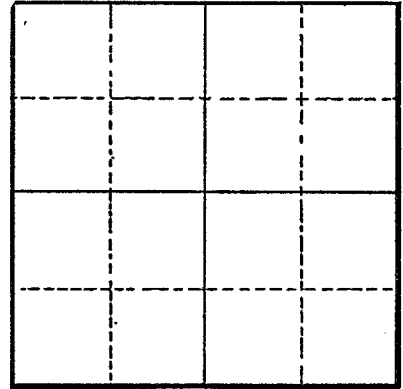

Section

Altitude at well 600

TYPE OF WELL: Drilled Date Constructed

Depth drilled 80 Depth cased

CASING RECORD:

8 inch

FINISH:

AQUIFERS:

Gravel and sand

WATER LEVEL:

16.1 feet below land surface on Nov. 7, 1947

PUMPING EQUIPMENT: Type Centrifugal H.P.
Capacity 300 G.P.M.

WELL TESTS:

Drawdown ft. after hours G.P.M.
Drawdown ft. after hours G.P.M.

USE OF WATER Irrigation Temp. °F., 19

SOURCE OF INFORMATION USGS

DRILLER or DIGGER

ADDITIONAL DATA:

Log Water Level Measurements Chemical Analysis Aquifer Test

REMARKS: