

STATE ENGINEER
Salem, Oregon

UMAT
4097

Well Record

STATE WELL NO. 6N/34-15J
COUNTY UMATILLA
APPLICATION NO. GR-2644

OWNER: Kenneth L. Dickerson

MAILING

ADDRESS: Rt. 1, Box 194

LOCATION OF WELL: Owner's No.


CITY AND

STATE: Walla Walla, Washington

NE 1/4 SE 1/4 Sec. 15 T. 6 N. S. R. 34 E. W.M.

Bearing and distance from section or subdivision

corner 85' S. and 221' W.

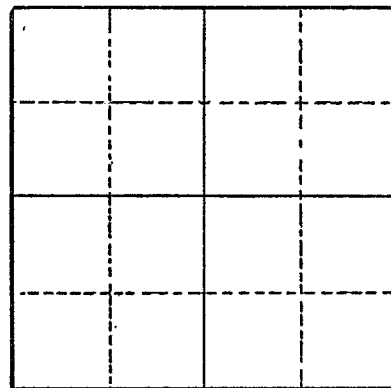

Altitude at well

TYPE OF WELL: Dug Date Constructed 1912

Depth drilled 30 Depth cased 20

Section

CASING RECORD:

48-inch

FINISH:

AQUIFERS:

WATER LEVEL:

7-feet

PUMPING EQUIPMENT: Type Centrifugal H.P. 15
Capacity 400 G.P.M.

WELL TESTS:

Drawdown ft. after hours G.P.M.

Drawdown ft. after hours G.P.M.

USE OF WATER Irrigation Temp. °F., 19

SOURCE OF INFORMATION GR-2506

DRILLER or DIGGER

ADDITIONAL DATA:

Log Water Level Measurements Chemical Analysis Aquifer Test

REMARKS: