

STATE ENGINEER  
Salem, Oregon

UMAT  
4123

# Well Record


STATE WELL NO. 6N/34-23A(1)  
COUNTY Umatilla  
APPLICATION NO. GR-1132

GR- 1092

OWNER: Edwin March  
MAILING ADDRESS: Rt. 2, Box 127

LOCATION OF WELL: Owner's No. CITY AND STATE: Milton-Freewater, Oregon

NE 1/4 NE 1/4 Sec. 23 T. 6 N. R. 34 E., W.M.  
Bearing and distance from section or subdivision  
corner 452' N. & 50' W. from SE cor. of NE 1/4 NE 1/4  
of Section 23.

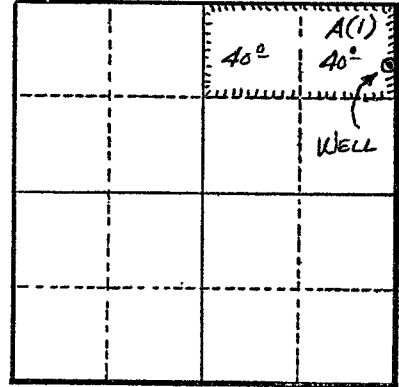

Altitude at well 750 ft.

TYPE OF WELL: Dug Date Constructed 1917

Depth drilled 14 ft. Depth cased 14 ft.

Section 23

### CASING RECORD:

6 ft. square plank curb

### FINISH:

### AQUIFERS:

### WATER LEVEL:

3 ft.

PUMPING EQUIPMENT: Type Rain-O-Flow Cent. H.P. 15  
Capacity 400 G.P.M.

### WELL TESTS:

Drawdown ft. after hours G.P.M.  
Drawdown ft. after hours G.P.M.

USE OF WATER Irrigation Temp. °F. 19

SOURCE OF INFORMATION G. R. Record

DRILLER or DIGGER

### ADDITIONAL DATA:

Log N.A. Water Level Measurements Chemical Analysis Aquifer Test

### REMARKS:

Irrigation of 80 acres.