

STATE ENGINEER
Salem, Oregon

UMAT
4135
UMAT Well Record

STATE WELL NO. 6N/34-24F(1)
COUNTY Umatilla
APPLICATION NO. GR-1139


GR- 1099

OWNER: John L. Richartz MAILING ADDRESS: Rt. 2, Box 129

LOCATION OF WELL: Owner's No. CITY AND STATE: Milton-Fewater, Oregon

SE 1/4 NW 1/4 Sec. 24 T. 6 N. W, R. 34 E.

Bearing and distance from section or subdivision corner 150' N. & 7' W. from Center of Sec. 24.

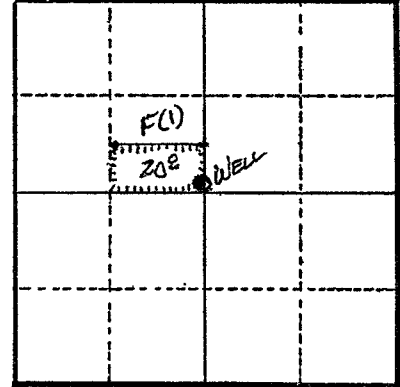

Altitude at well 750 ft.

TYPE OF WELL: Drilled Date Constructed 1918

Depth drilled 50 ft. Depth cased 25 ft.

Section 24

CASING RECORD:

- 10 inch from 8 to 13 ft.
- 8 inch from 13 to 33 ft.

FINISH:

AQUIFERS:

Gravel

WATER LEVEL:

16 ft.

PUMPING EQUIPMENT: Type Sterling Cent. 3 in. H.P. 3
Capacity 350 G.P.M.

WELL TESTS:

Drawdown 22 ft. after _____ hours 300 G.P.M.
Drawdown _____ ft. after _____ hours _____ G.P.M.

USE OF WATER Irrigation Temp. _____ °F., 19 _____

SOURCE OF INFORMATION G. R. Record

DRILLER or DIGGER _____

ADDITIONAL DATA:

Log N.A. Water Level Measurements _____ Chemical Analysis _____ Aquifer Test _____

REMARKS:

Irrigation of 20 acres.