

STATE ENGINEER
Salem, Oregon

UMAT
4156

Well Record

STATE WELL NO. 6N/34-25J
COUNTY UMATILLA
APPLICATION NO. GR-2091

OWNER: Thaddeus D. Shepherd


MAILING ADDRESS: Milton Freewater

LOCATION OF WELL: Owner's No.

CITY AND STATE: Oregon

NE ¼ SE ¼ Sec. 25 T. 6 N. R. 34 E., W.M.

Bearing and distance from section or subdivision corner 175' W & 170' S from E ¼ cor

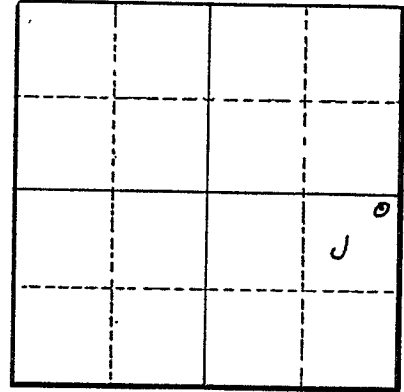

Section 25

Altitude at well

TYPE OF WELL: Dug-drilled Date Constructed 1913

Depth drilled 70' Depth cased

CASING RECORD:

FINISH:

AQUIFERS:

WATER LEVEL: 26'

PUMPING EQUIPMENT: Type Centrifugal H.P. 3
Capacity 200 G.P.M.

WELL TESTS:

Drawdown ft. after hours G.P.M.
Drawdown ft. after hours G.P.M.

USE OF WATER Irrigation Temp. °F., 19

SOURCE OF INFORMATION GR-3916

DRILLER or DIGGER

ADDITIONAL DATA:

Log NA Water Level Measurements Chemical Analysis Aquifer Test

REMARKS: