

STATE ENGINEER
Salem, Oregon

UMAT 4184
UMAT 4184
Well Record

STATE WELL NO. 6N/34-36N(1)
COUNTY Umatilla
APPLICATION NO. U- 636

OWNER: Ernest Key


MAILING ADDRESS: Rt. 2 Box 104

LOCATION OF WELL: Owner's No. 1

CITY AND STATE: Milton-Freewater, Oregon

SW 1/4 SW 1/4 Sec. 36 T. 6 N. 34 R. 34 W., W.M.

Bearing and distance from section or subdivision corner N. 43° 16' 50" E. 1824.8' from SW cor. sec. 36

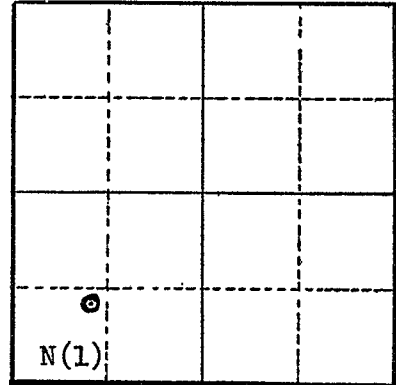

Altitude at well

TYPE OF WELL: Drilled Date Constructed

Depth drilled 300' Depth cased 255'

Section 36

CASING RECORD:

12 inch set from 0 to 132 1/2 feet
10 inch set from 108 1/2 to 255 feet

FINISH:

Open hole from 255 to 300 feet

AQUIFERS:

Basalt

WATER LEVEL:

Flows 1200 gpm

PUMPING EQUIPMENT: Type Turbine H.P. 50
Capacity G.P.M.

WELL TESTS:

Drawdown ft. after hours G.P.M.
Drawdown ft. after hours G.P.M.

USE OF WATER Irrigation Temp. °F. 19

SOURCE OF INFORMATION U- 673

DRILLER or DIGGER Yager

ADDITIONAL DATA:

Log X Water Level Measurements Chemical Analysis Aquifer Test

REMARKS:

Cannot measure when pump is operating, hose bib outlet will permit pressure measurements when pump is not operating. 8/7/57 jes

UMAT 4185


UMAT 4184

ERNEST KEY WELL # 2

PUMPED 1300 GAL. PER MIN.
 STATIC WATER LEVEL 29'
 DRAW DOWN 5' at 1500 G.P.M.
 " " 6 1/2' at 1500 G.P.M.

ERNEST KEY WELL # 1

WELL FLOW 1200 G.P.M

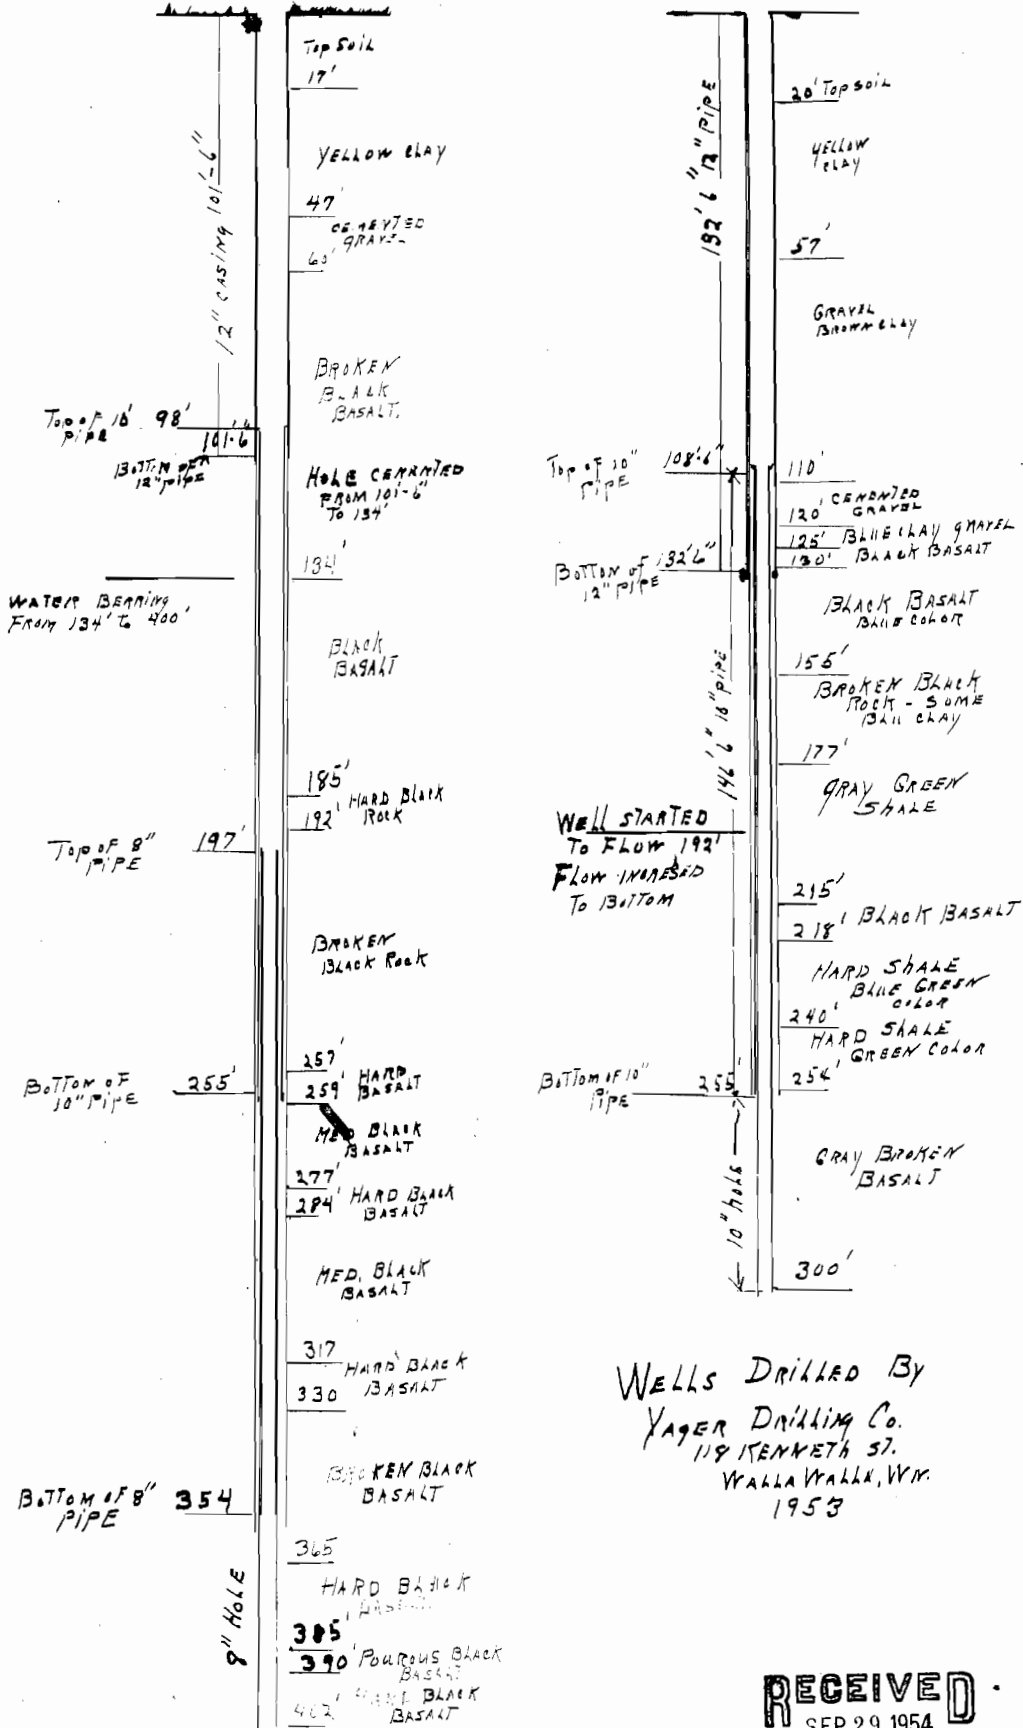

WELLS DRILLED BY
 YAGER DRILLING CO.
 119 KENNETH ST.
 WALLA WALLA, WY.
 1953

RECEIVED
 SEP 29 1954
 STATE ENGINEER
 SALEM, OREGON

101'-6" of 12" PIPE
 157' of 10" PIPE
 158' 10" of 8" PIPE