



Well Record

STATE WELL NO. 6N/35-13J(2)
COUNTY Umatilla
APPLICATION NO. U- 432

OWNER: Carl A. Anderson

MAILING
ADDRESS:

1231 Figueroa

LOCATION OF WELL: Owner's No. _____


CITY AND
STATE:

Walla Walla, Washington

NE $\frac{1}{4}$ SE $\frac{1}{4}$ Sec. 13 T. 6 N. ~~XX~~ R. 35 E. ~~XX~~, W.M.

Bearing and distance from section or subdivision

corner 1320' N. thence N.45°54'W. 50' from SE
cor. of sec. 13.

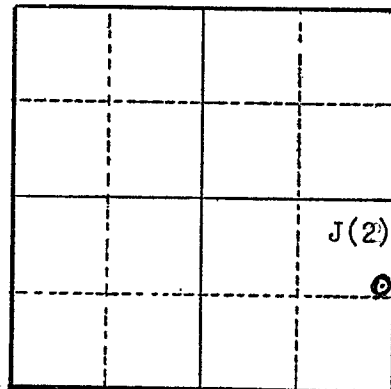

Altitude at well _____

TYPE OF WELL: Drilled Date Constructed 1943

Depth drilled 128' Depth cased _____

Section 13

CASING RECORD:

FINISH:

AQUIFERS:

WATER LEVEL:

12 feet

0.6 feet (11/14/58)

PUMPING EQUIPMENT: Type _____

H.P. _____

Capacity _____ G.P.M.

WELL TESTS:

Drawdown _____ ft. after _____ hours _____ G.P.M.

Drawdown _____ ft. after _____ hours _____ G.P.M.

USE OF WATER Irrigation

Temp. _____ °F. _____, 19____

SOURCE OF INFORMATION U- 397

DRILLER or DIGGER _____

ADDITIONAL DATA:

Log NA Water Level Measurements _____ Chemical Analysis _____ Aquifer Test _____

REMARKS: