

STATE ENGINEER
Salem, Oregon

UMAT
4211

Well Record

STATE WELL NO. 6N/35-13P
COUNTY Umatilla
APPLICATION NO. GR-4138

OWNER: Grandview Irrigation Co.
% Mrs. Glen Fisher, Secty.


MAILING ADDRESS: Route 3

LOCATION OF WELL: Owner's No. _____

CITY AND STATE: Milton-Freewater, Oregon

SE 1/4 SW 1/4 Sec. 13 T. 6 N. E. S. R. 35 W., W.M.

Bearing and distance from section or subdivision
corner 300' W. & 50' S. of NE Cor. Lot 20

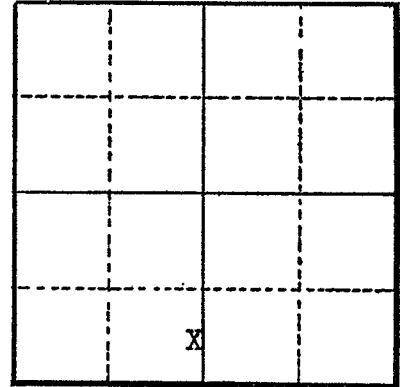

Section 13

Altitude at well _____

TYPE OF WELL: Drilled Date Constructed prior 1911

Depth drilled 618 ft. Depth cased 350 ft.

CASING RECORD:

6 inch steel casing set to 350 feet

FINISH:

AQUIFERS:

WATER LEVEL:

PUMPING EQUIPMENT: Type 6" turbine H.P. 15
Capacity 300 G.P.M.

WELL TESTS:

Drawdown 90 ft. after _____ hours 300 G.P.M.

Drawdown _____ ft. after _____ hours _____ G.P.M.

USE OF WATER Irrigation Temp. _____ °F., 19

SOURCE OF INFORMATION Well Registration Statement Cert. # GR-3713

DRILLER or DIGGER A. A. Durand

ADDITIONAL DATA:

Log Water Level Measurements _____ Chemical Analysis _____ Aquifer Test _____

REMARKS: Log

Sand & gravel clay
Blue clay
Water bearing strata

Thickness	Depth to Bottom
200	200
350	550
68	618