

STATE ENGINEER
Salem, Oregon

UMAT
4238

Well Record

GR- 1095

STATE WELL NO. 6N/35-14I(1)
COUNTY Umatilla
APPLICATION NO. GR- 1135

OWNER: Herman Miller

MAILING ADDRESS: Rt. 3, Box 97


LOCATION OF WELL: Owner's No.

CITY AND STATE: Milton-Freewater, Oregon

NE 1/4 SW 1/4 Sec. 14 T. 6 N. R. 35 E. W.M.

Bearing and distance from section or subdivision

corner 200' W. & 15' N. from the SE cor. of the
NE 1/4 SW 1/4 of Section 14.

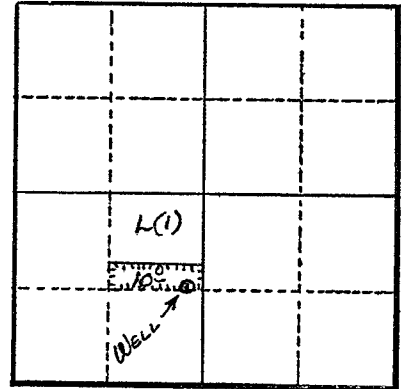

Section 14

Altitude at well 925 ft.

TYPE OF WELL: Dug Date Constructed 1910

Depth drilled 18 ft. Depth cased

CASING RECORD:

60 inch hole

FINISH:

AQUIFERS:

WATER LEVEL:

8 ft.

PUMPING EQUIPMENT: Type Berkeley high head 2 x 1 1/2 in. H.P. 3
Capacity G.P.M.

WELL TESTS:

Drawdown 16 ft. after 100 hours G.P.M.

Drawdown ft. after hours G.P.M.

USE OF WATER Irrigation Temp. °F. 19

SOURCE OF INFORMATION G. R. Record

DRILLER or DIGGER

ADDITIONAL DATA:

Log N.A. Water Level Measurements Chemical Analysis Aquifer Test

REMARKS:

Irrigation of 10 acres.