

STATE ENGINEER  
Salem, Oregon

UMAT  
4242

# Well Record

GR- 1222

STATE WELL NO. 6N-35-14M(1)  
COUNTY Umatilla  
APPLICATION NO. GR-1182

OWNER: Charles Eiffert

MAILING  
ADDRESS: \_\_\_\_\_


LOCATION OF WELL: Owner's No. \_\_\_\_\_

CITY AND  
STATE: Milton-Freewater, Oregon

NW  $\frac{1}{4}$  SW  $\frac{1}{4}$  Sec. 14 T. 6 N. 35 E. 14 W.M.

Bearing and distance from section or subdivision

corner 900' E. & 200' S. from W $\frac{1}{4}$  cor. Sec. 14.

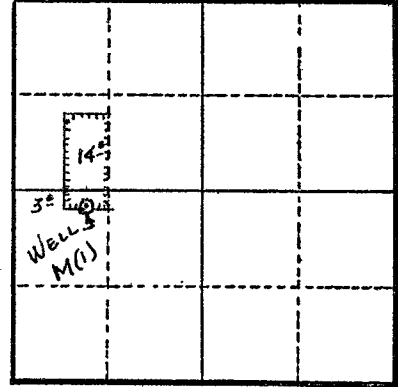

Section 14

Altitude at well 750 ft.

TYPE OF WELL: Dug & Drilled Date Constructed 1919

Depth drilled 60 ft. Depth cased 32 ft.

### CASING RECORD:

Dug (6' x 6') from 0 to 20 ft.

Drilled from 20 to 60 ft. (Cased with 6 $\frac{1}{4}$  in. from 20 to 32 ft.)

### FINISH:

### AQUIFERS:

### WATER LEVEL:

20 ft.

PUMPING EQUIPMENT: Type Pacific Cent. H.P. 3  
Capacity 300 G.P.M.

### WELL TESTS:

Drawdown 12 ft. after \_\_\_\_\_ hours 300 G.P.M.

Drawdown \_\_\_\_\_ ft. after \_\_\_\_\_ hours \_\_\_\_\_ G.P.M.

USE OF WATER Irrigation Temp. \_\_\_\_\_ °F., 19 \_\_\_\_\_

SOURCE OF INFORMATION G.R. Record

DRILLER or DIGGER Jim Overturf

### ADDITIONAL DATA:

Log N.A. Water Level Measurements \_\_\_\_\_ Chemical Analysis \_\_\_\_\_ Aquifer Test \_\_\_\_\_

### REMARKS:

Irrigation of 17 acres.