

STATE ENGINEER
Salem, Oregon

UMAT
4263

Well Record

STATE WELL NO. 6N/35-16K1
COUNTY UMATILLA
APPLICATION NO. _____

OWNER: P. E. Oliver


MAILING ADDRESS: _____

LOCATION OF WELL: Owner's No. _____

CITY AND STATE: _____

..... 1/4 1/4 Sec. T. N. E.
S., R. W., W.M.

Bearing and distance from section or subdivision corner _____

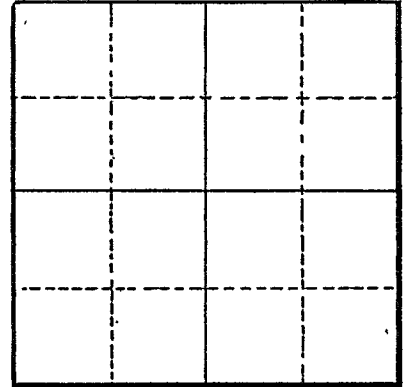

Section _____

Altitude at well 755

TYPE OF WELL: Drilled, Date Constructed _____

Depth drilled 171 ^{Dug} Depth cased _____

CASING RECORD:

60-8 inch

FINISH:

AQUIFERS:

Gravel

WATER LEVEL:

25 feet below land surface, 1948

PUMPING EQUIPMENT: Type Turbine H.P. _____

Capacity 180 G.P.M.

WELL TESTS:

Drawdown _____ ft. after _____ hours _____ G.P.M.

Drawdown _____ ft. after _____ hours _____ G.P.M.

USE OF WATER Irrigation Temp. _____ °F. _____, 19_____

SOURCE OF INFORMATION USGS

DRILLER or DIGGER _____

ADDITIONAL DATA:

Log _____ Water Level Measurements _____ Chemical Analysis _____ Aquifer Test _____

REMARKS: